


T.16S.,R.6W.,W.M.

Section 36

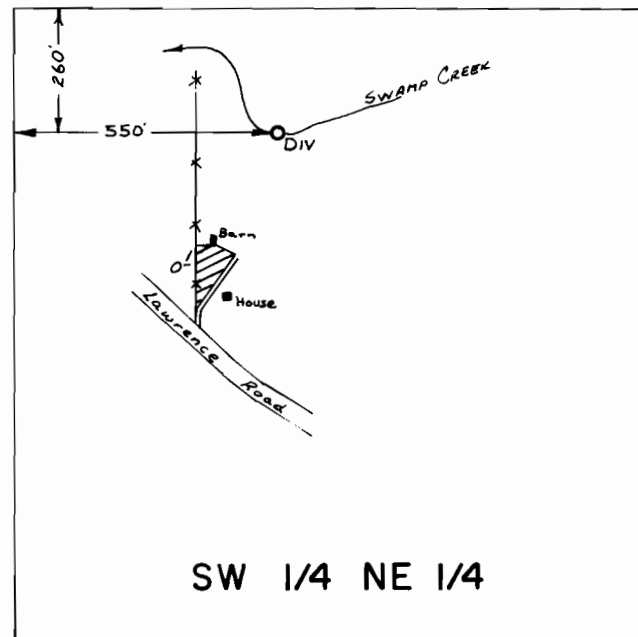

SCALE: 1" = 400'

FINAL PROOF SURVEY
UNDER

Application No. 52541 Permit No. 39647.....
IN NAME OF

DAVID L. ROWE

Surveyed May 6, 1980, by S.C. BROWN.....