


# T. 1 S. R. 32 E. W. M.

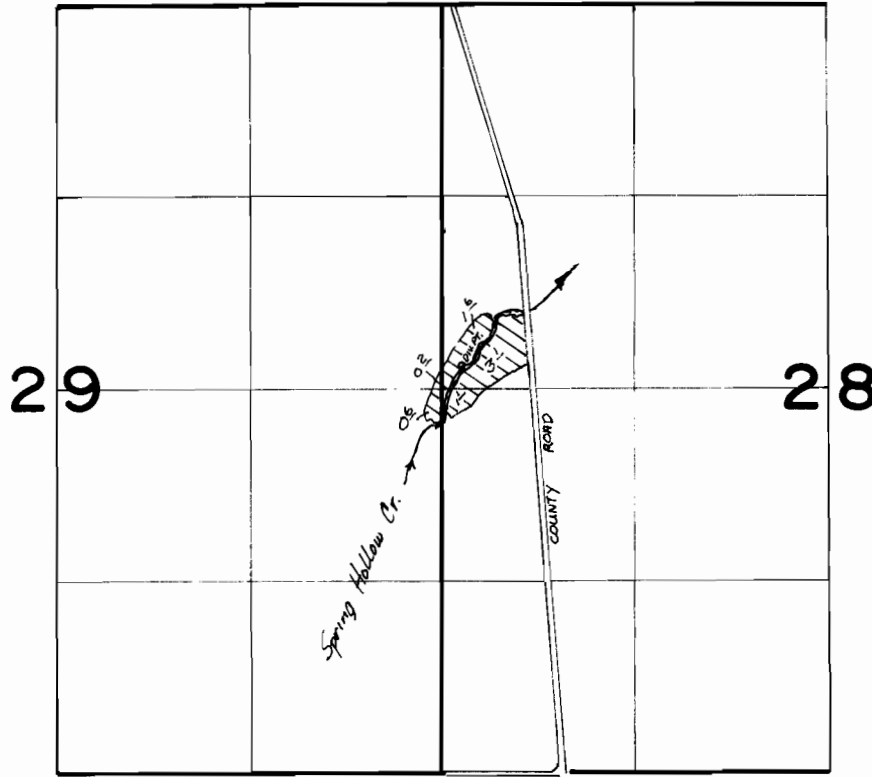

SCALE: 1" = 1320'



DIV. PT. LOCATED 150' NORTH AND 140' EAST FROM 1/4 COR. 29|28

## FINAL PROOF SURVEY UNDER

Application No. 54243 Permit No. 40629.....  
IN NAME OF

.....FLOYD L. & EUDORA WILSON.....

Surveyed ...6-1..... 1984., by V.L. CHURCH.....