


T. 4 S., R. 1 E., W. M.

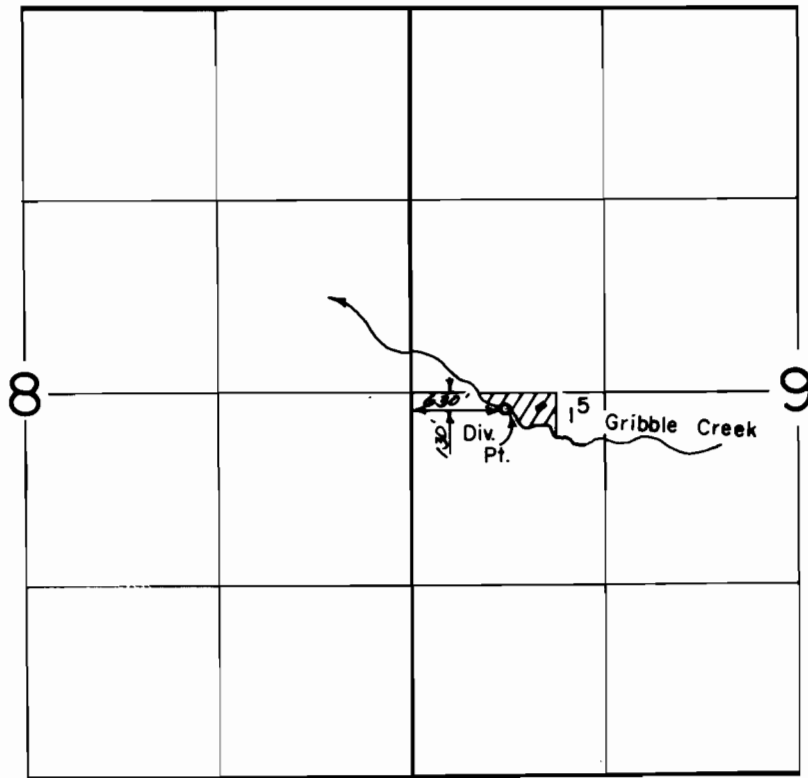

**FINAL PROOF SURVEY**  
UNDER

Application No. 55208 Permit No. 41409

IN NAME OF

FREDERICK W. EGGER

Surveyed MAY 20, 1980, by *A. Brown*

DFK-266-145