


T. 24 S., R. 7 W., W. M.
SECTIONS 31 & 32

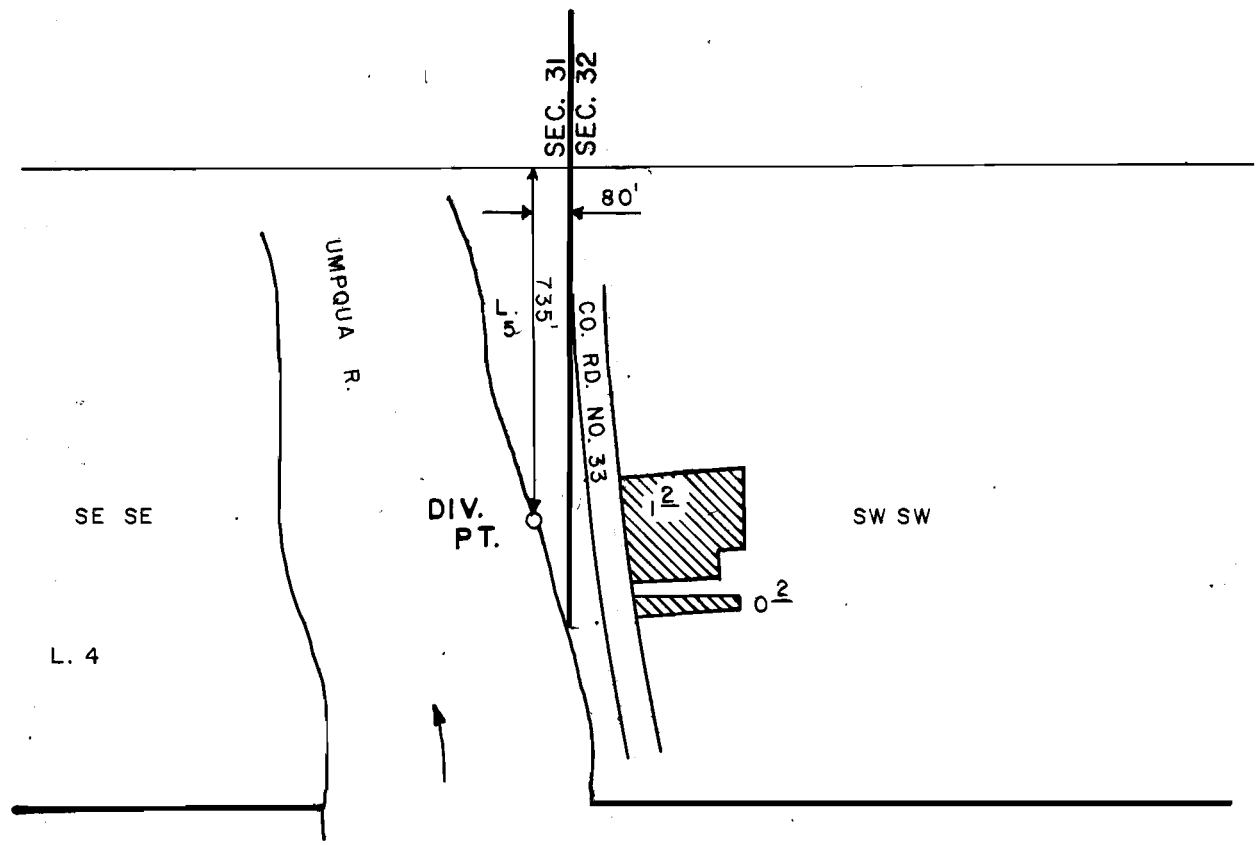

SCALE 1" = 400'

FINAL PROOF SURVEY
UNDER

Application No. 55829 Permit No. 41889
IN NAME OF

JAMES G. WYLE

Surveyed AUG. 13, 1986, by J. M. SCHMORDE

REVISED 6/10/87 LN

PHOTO: SEC. 32, T. 24 S., R. 7 W. 1982-83/ZOOM JK