


T.IOS. R.IOW. W.M.

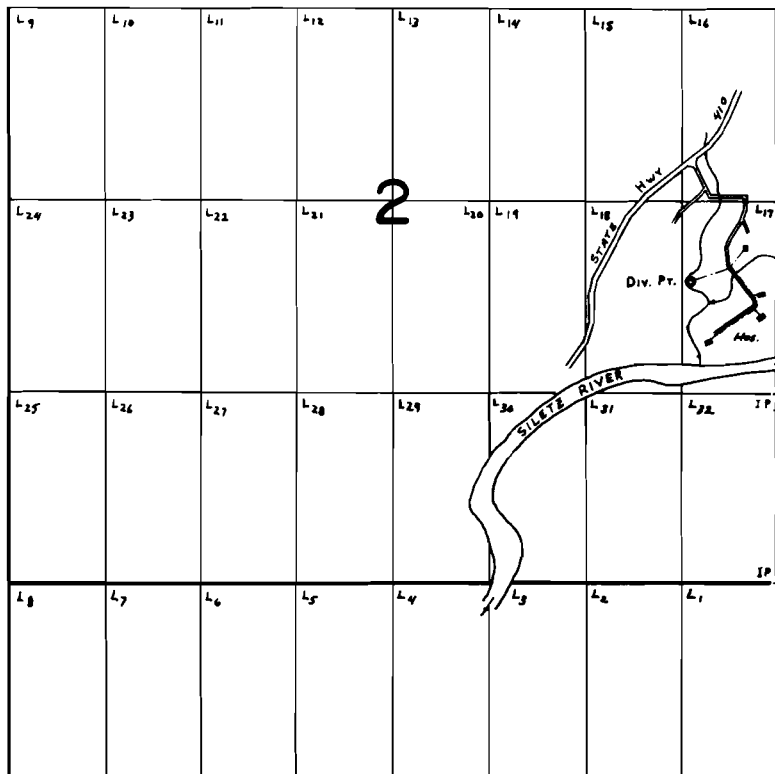

Div. Pt. Loc: 770' N. } 600' W. fr. SE. Cor. Lot 17.

FINAL PROOF SURVEY UNDER

Application No. .56305. Permit No. .42399.....
IN NAME OF

.....RICHARD E. WRIGHT.....

Surveyed May...22.. 19.80, by ..C.L.Hughes.....