




T. 4 S., R 3 E., W.M.

SECTION 17

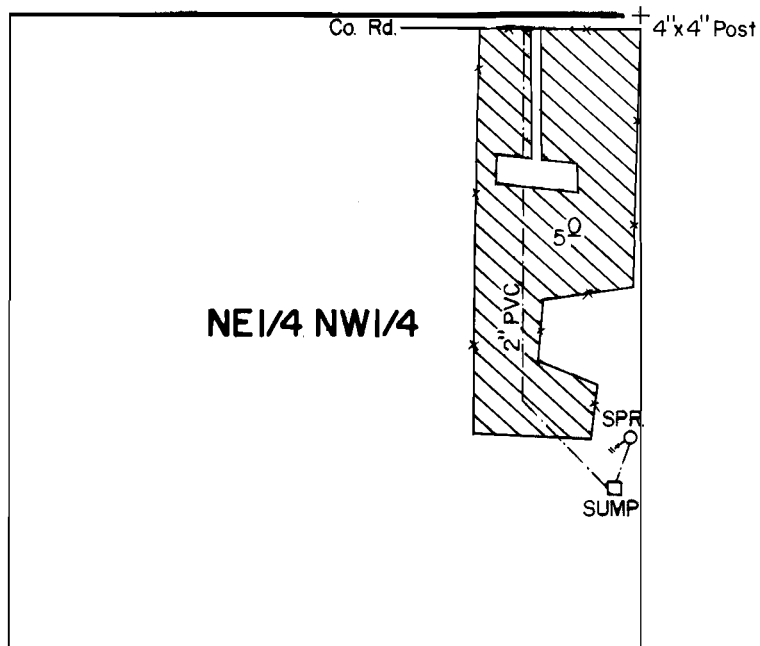

DIV. PT. LOC.: 880' S. & 25' W. FROM N. 1/4 CORNER SEC. 17

SCALE: 1" = 400'

FINAL PROOF SURVEY
UNDER

Application No. 56406 Permit No. 42500
IN NAME OF

HENRY G. EHLEINGER

Surveyed JULY 11, 1986, by T. WARREN