


T.17S., R.8W., W.M.

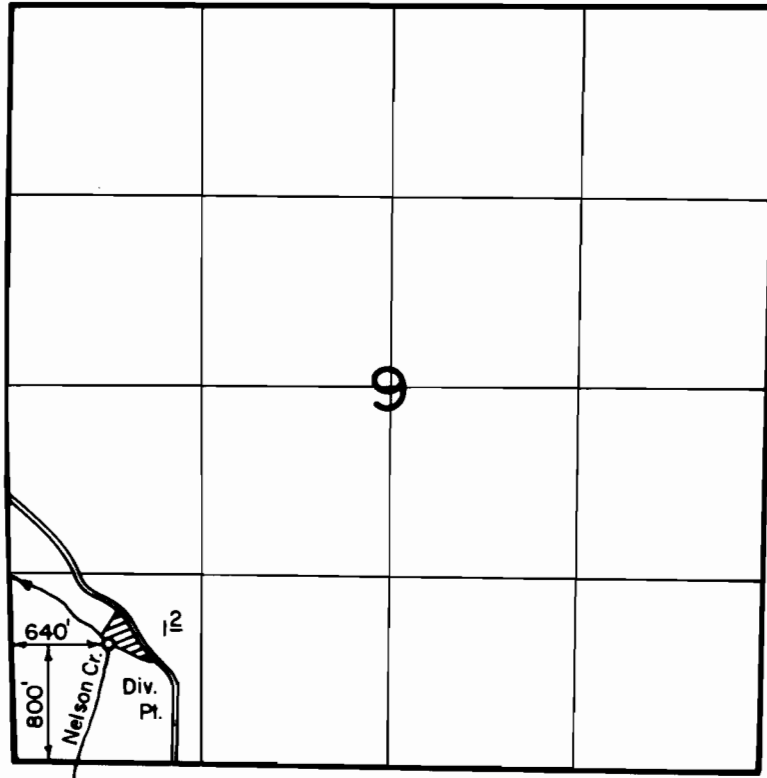

FINAL PROOF SURVEY
UNDER

Application No. 56839 Permit No. 42686....

IN NAME OF

EARL L. RAUDEBAUGH

Surveyed MAY 13, 1980, by *Alton*.....