


T.17S., R. 9W., W.M.

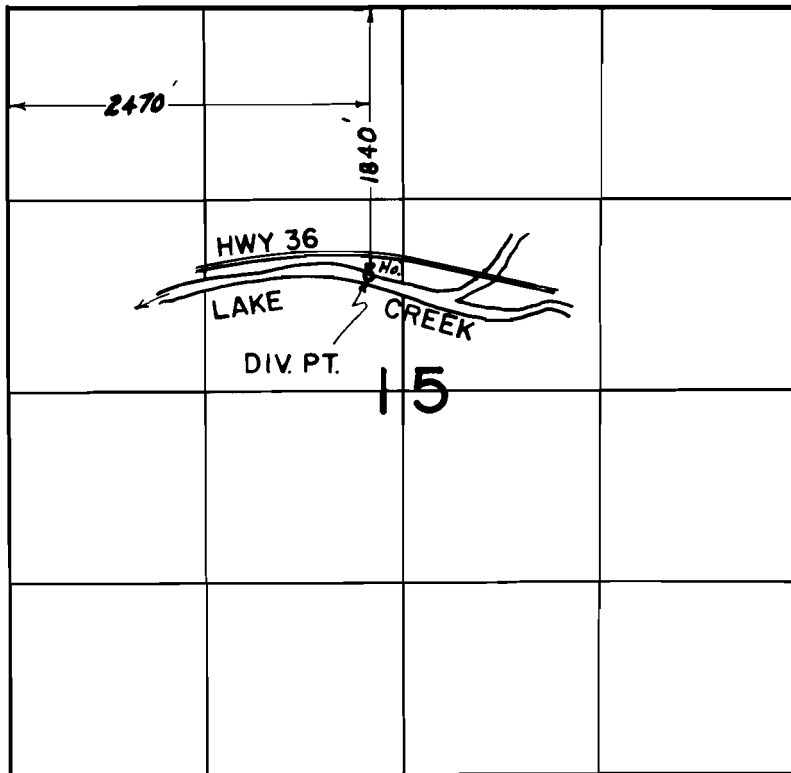

**FINAL PROOF SURVEY**  
UNDER

Application No. 58299..... Permit No. 43918.....  
IN NAME OF

**JOHN W. BILLINGTON & GARY K. JENSEN**

Surveyed MAY.25... 19.79, by R.G.MUCKEN.....