


T.9S., R.1E., W.M.

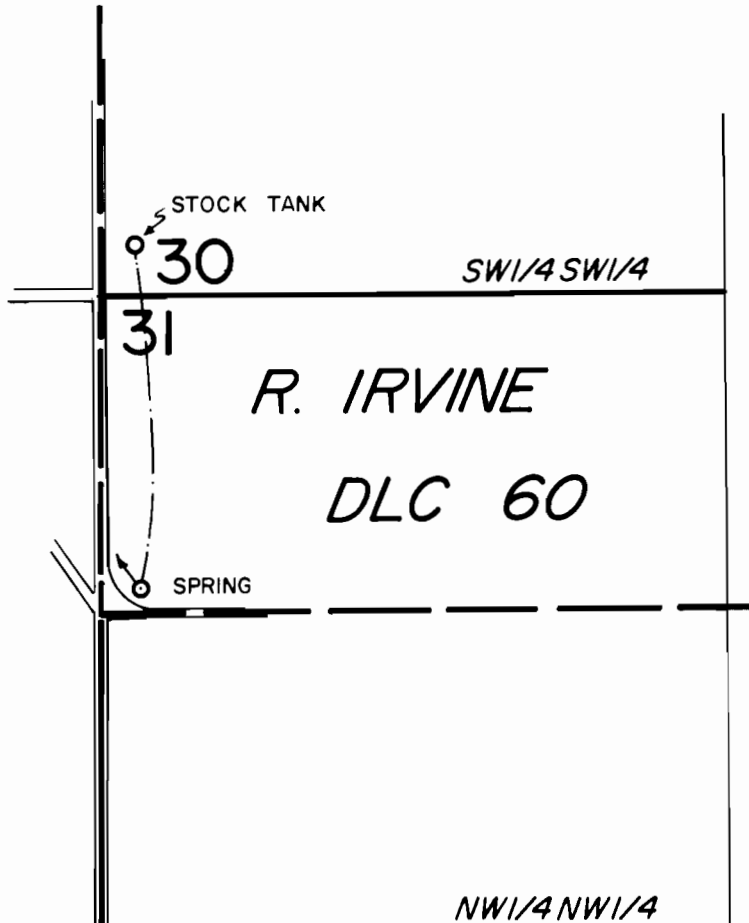

SPRING LOC.: 50' N. & 80' E. from the SW corner IRVINE DLC 60

SCALE 1" = 400'

FINAL PROOF SURVEY
UNDER

Application No. 59012... Permit No. 44413.....

IN NAME OF

HASKEL N. HUNTLEY

Surveyed MAY 1, 1980, by *d.B. Brown*