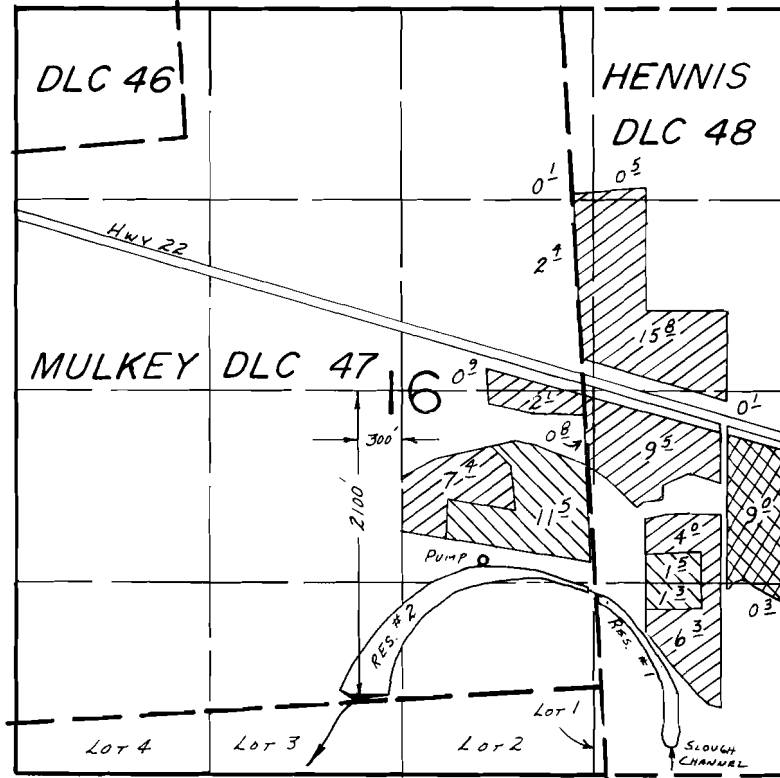
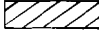

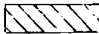


T.9S.,R.1E.,W.M.



SCALE: 1"=1320'

-  Primary from reservoir #2 and slough channel.
-  Supplemental from reservoir and slough.
-  Supplemental - stored water only.

FINAL PROOF SURVEY UNDER

R-58811 R-8135
 Application No. ...58812. Permit No.44873..
 IN NAME OF

.....VERNON R. MORGAN.....

Surveyed April 24, 1985, by P.R. PAGTER.....