




T.6 S., R.10 & 11 W., W.M.

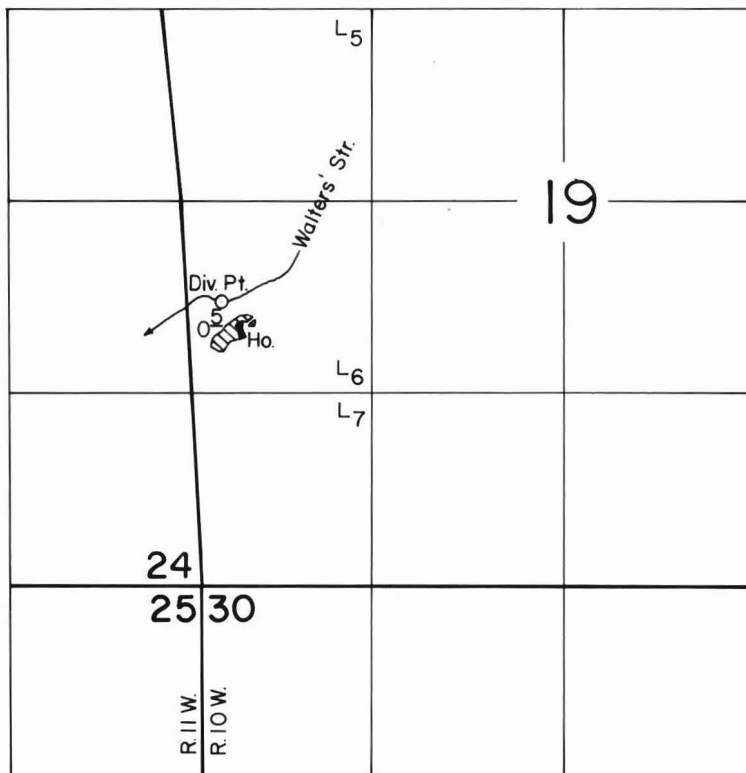

DIV. PT. LOC.: 1960' N. & 140' E. FROM SW. CORNER SECTION 19

SCALE: 1" = 1320'

FINAL PROOF SURVEY UNDER

Application No. 60570... Permit No. 45670.....
IN NAME OF

.....HOWARD LEON WALTERS.....

Surveyed JUNE 16, 1986, by T. WARREN.....