




T. 6 S., R. 10 W., W.M.

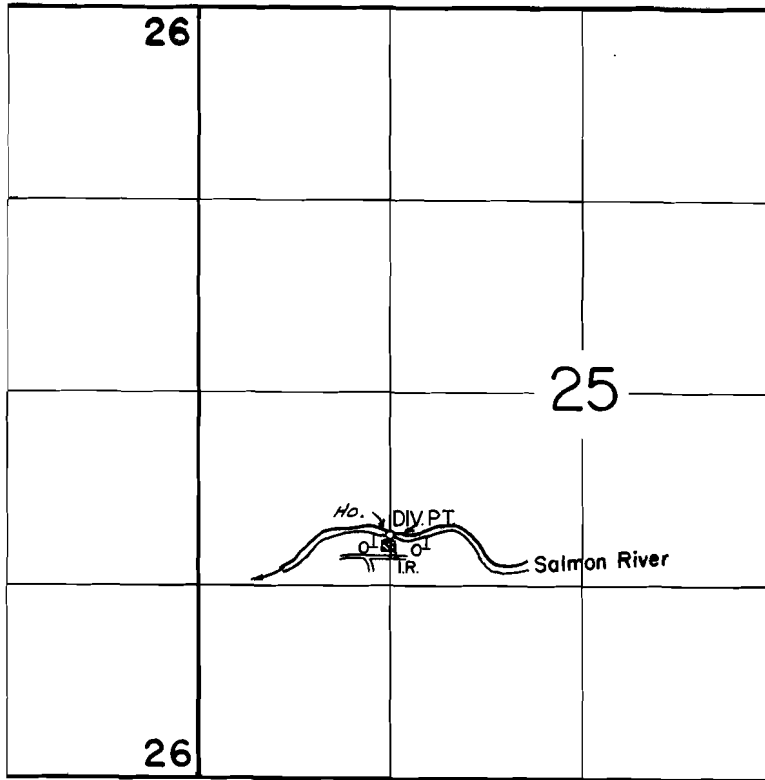

DIV.PT.LOC: 980'S. & 10'W. FROM NE. CORNER N.W.1/4 SW1/4 SEC. 25

SCALE: 1" = 1320'

**FINAL PROOF SURVEY**  
UNDER

Application No. 62244... Permit No. 46045.....  
IN NAME OF

.....GERALD F. JELI.....

Surveyed JUNE 19, 1986, by T. WARREN.....