

RECEIVED

JAN 19 1982

DEPT.

RECEIVED


JAN 12 1982

WATER RESOURCES DEPT.  
SALEM, OREGON

RECEIVED

JAN 19 1982

WATER RESOURCES DEPT.  
SALEM, OREGON

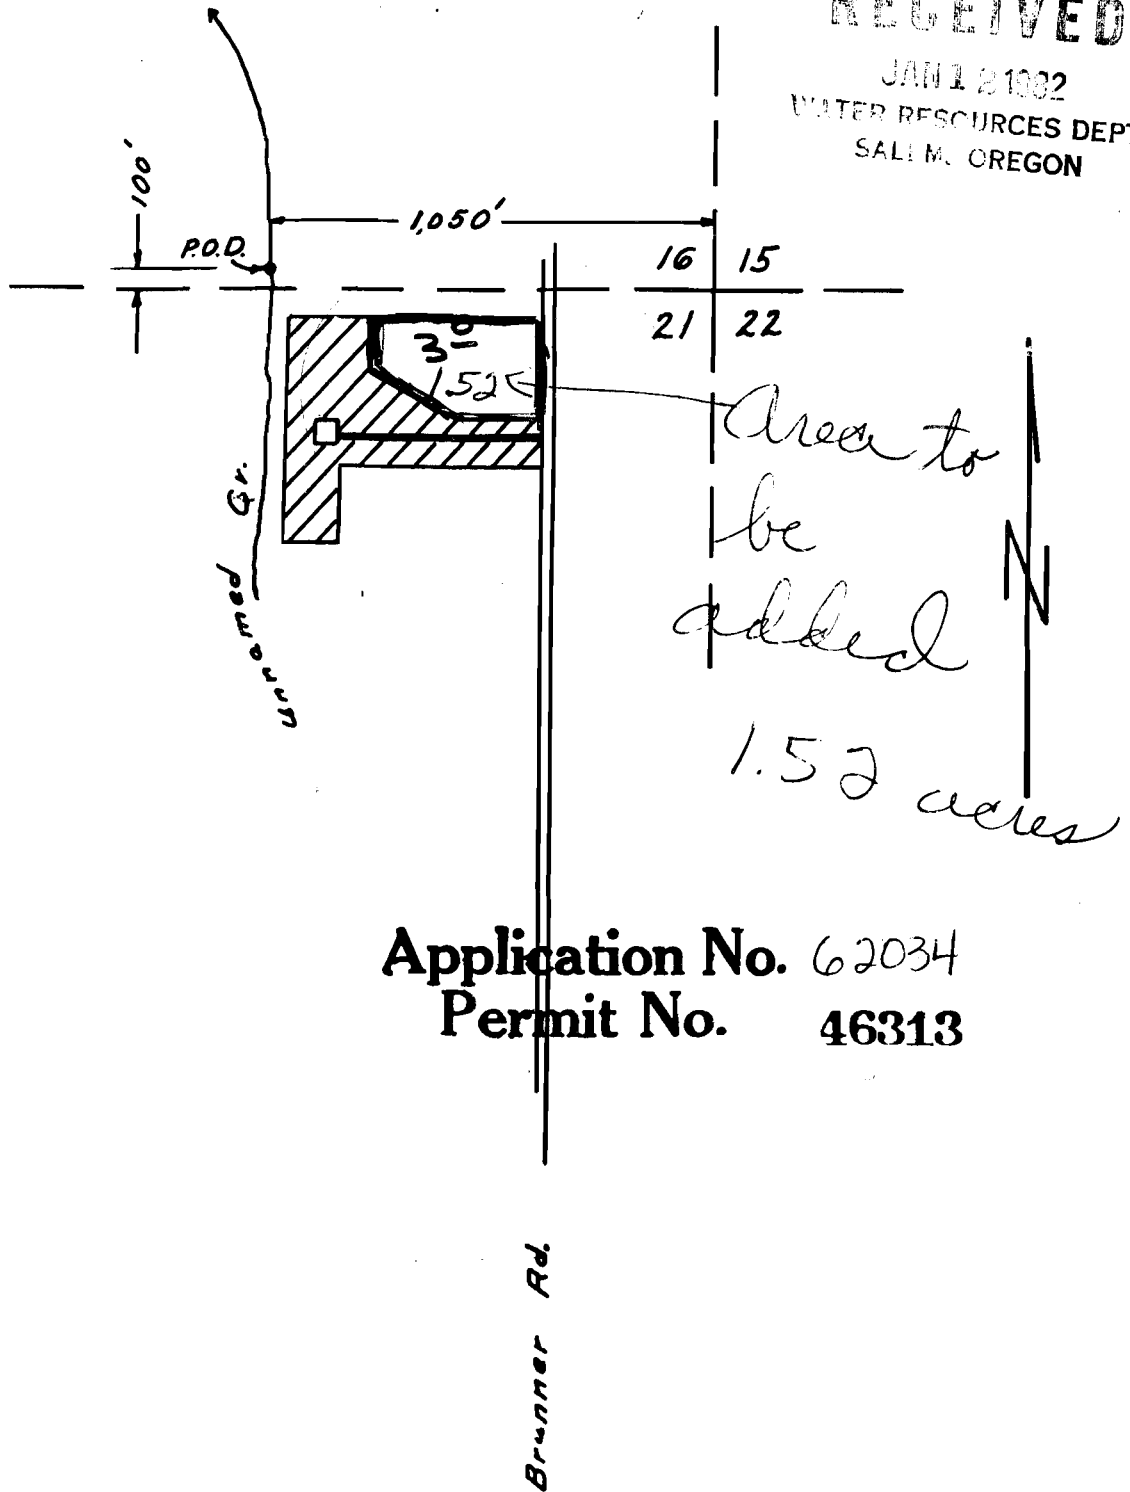

Application No. 55727  
 Permit No. 41335

Application No. 62034  
 Permit No. 46313

Application Map for Norman Beyl

1" = 450'

Drawn By K. Palmer

Accepted By *[Signature]*

T.2S. R.2E.