


T.40S. R.13W., W.M.

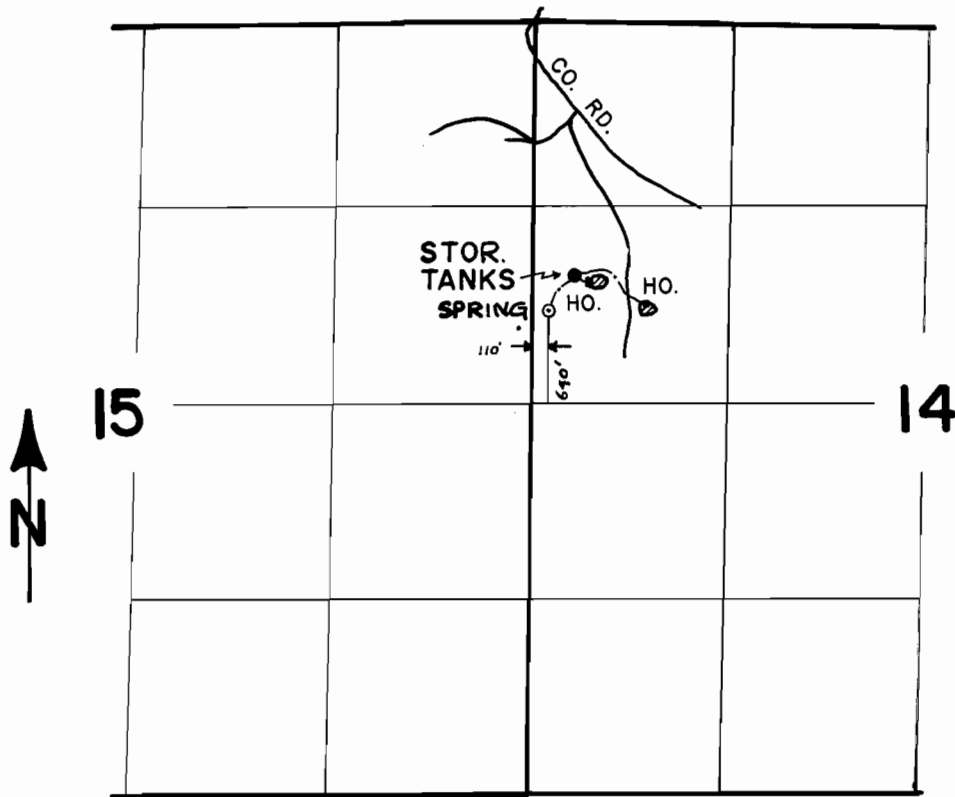

SCALE: 4" = 1 MILE

FINAL PROOF SURVEY
UNDER

Application No. 63430 Permit No. 46776
IN NAME OF

TOM WRAITH

Surveyed OCT. 9 1985, by J. M. SCHMORDE