


4678d  
56741

# T.37S., R. 8&9E., W.M.

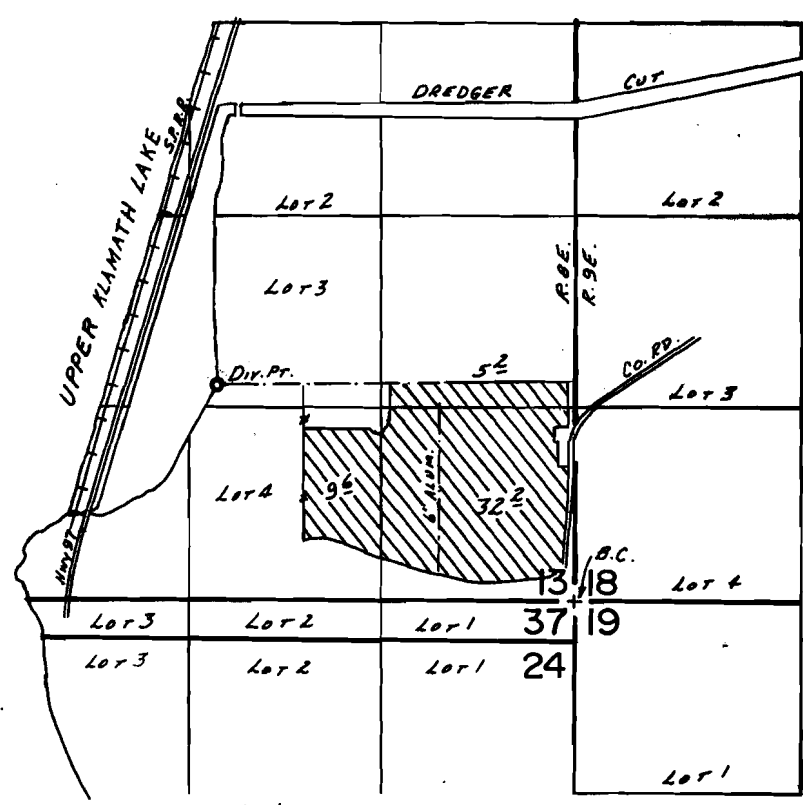

DIV. PT. LOC.: 1470 N. & 2450 W. FROM SE COR. SEC. 13

SCALE: 1" = 1320'

## FINAL PROOF SURVEY UNDER

Application No. 63938.. Permit No. 46982.....  
IN NAME OF

GLEND A J., DOROTHY M. & GLEN W. BUCHANAN

Surveyed Sept. 16... 1986, by B.W. BISHOP

1-20-87  
BWB

CNO-1JJ-187