


# T.26S.,R.4W.,W.M.

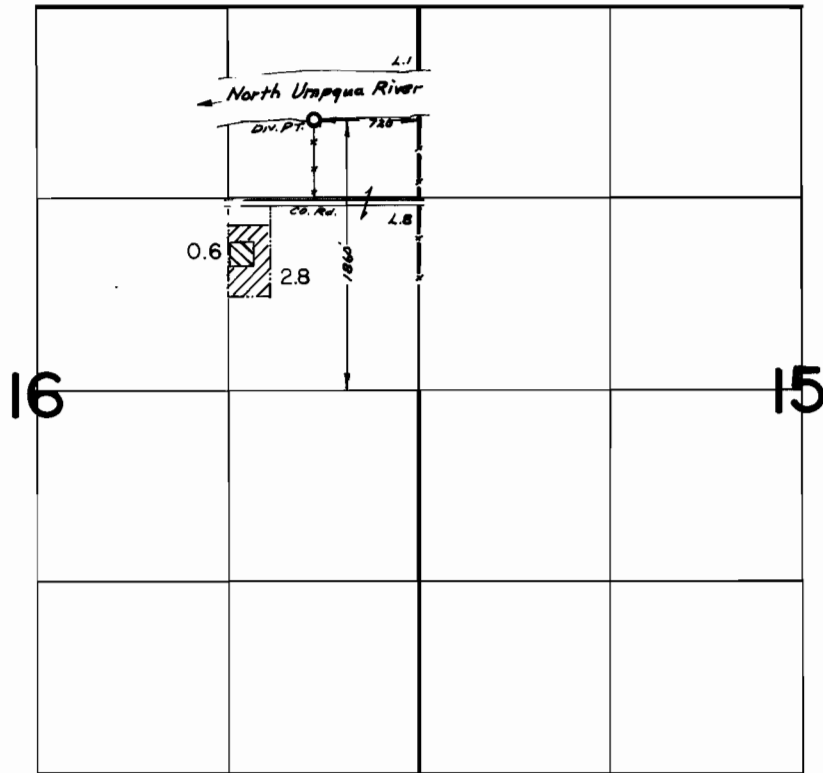

## FINAL PROOF SURVEY UNDER

Application No. 67105 Permit No. 48181  
50510 38142 

IN NAME OF

**FLOYD N. WILSON**

Surveyed Aug. 20, 1981, by L. TOLL  
Sep. 9, 1986 J.M. SCHMORDE