
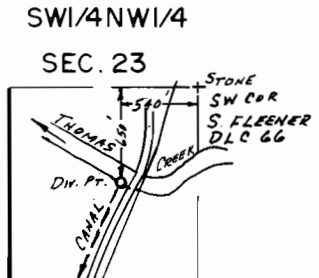


T. 10S., R. 2W., W.M.

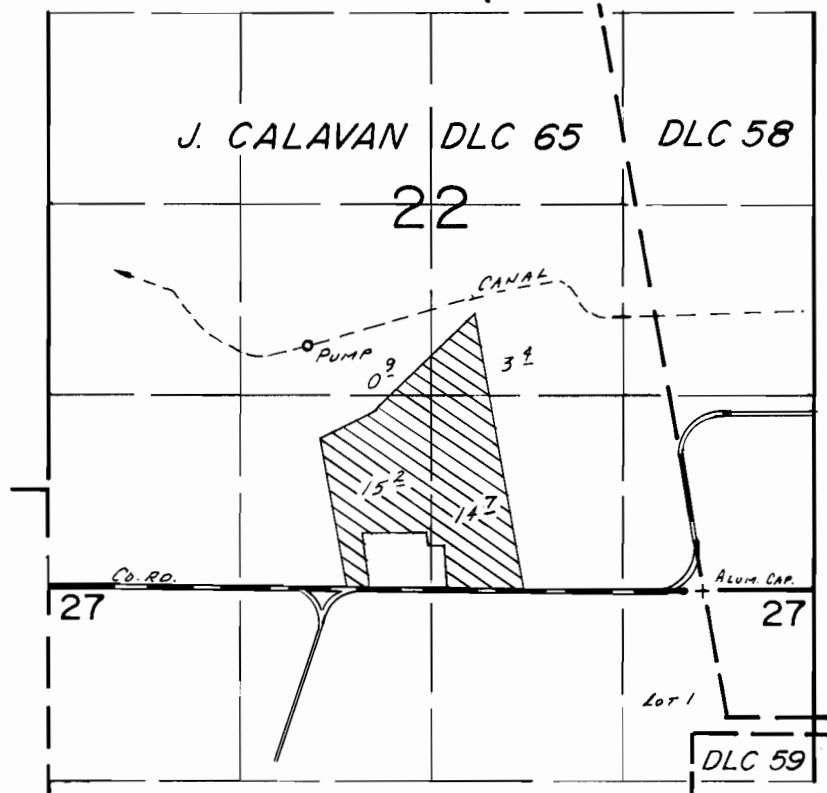

W/in R. Pollard
DLC 58

SCALE: 1" = 1320'

FINAL PROOF SURVEY UNDER

Application No. 68160... Permit No. 48764...
IN NAME OF

..... ERNEST J. VAN LEEUWEN

Surveyed Sept. 25, 1986, by B.W. BISHOP.....

1/13/87
BWB