


# T. 36S., R. 1 W., W.M.

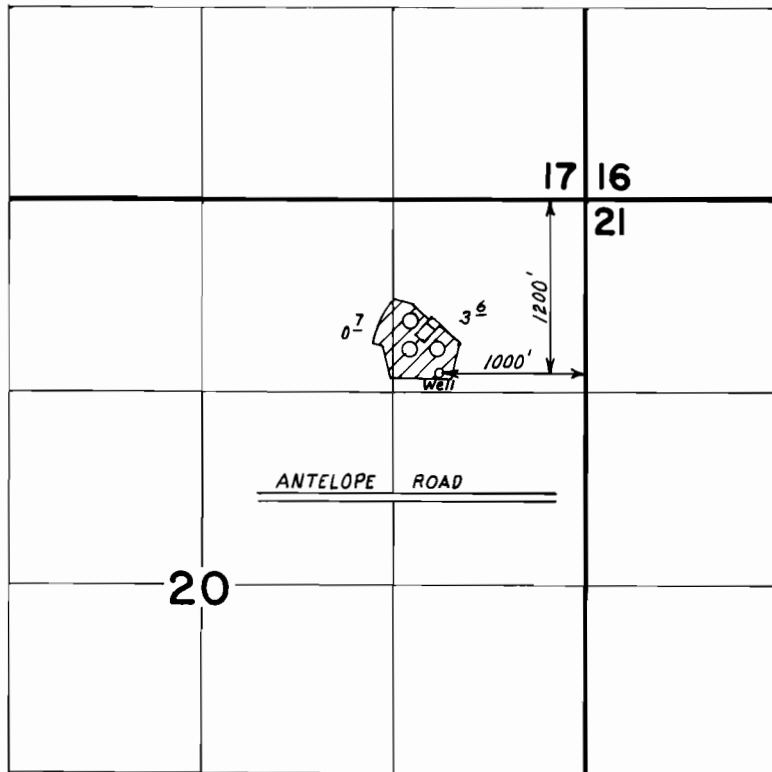

SCALE: 1" = 1320'

## FINAL PROOF SURVEY UNDER

Application No. **G-4788** Permit No. **G-4514**  
IN NAME OF

**WHITE CITY SCHOOL**

Surveyed **JUNE 14, 1984**, by **TIM W. BURKS**