


T.38S. R. 10E W.M.

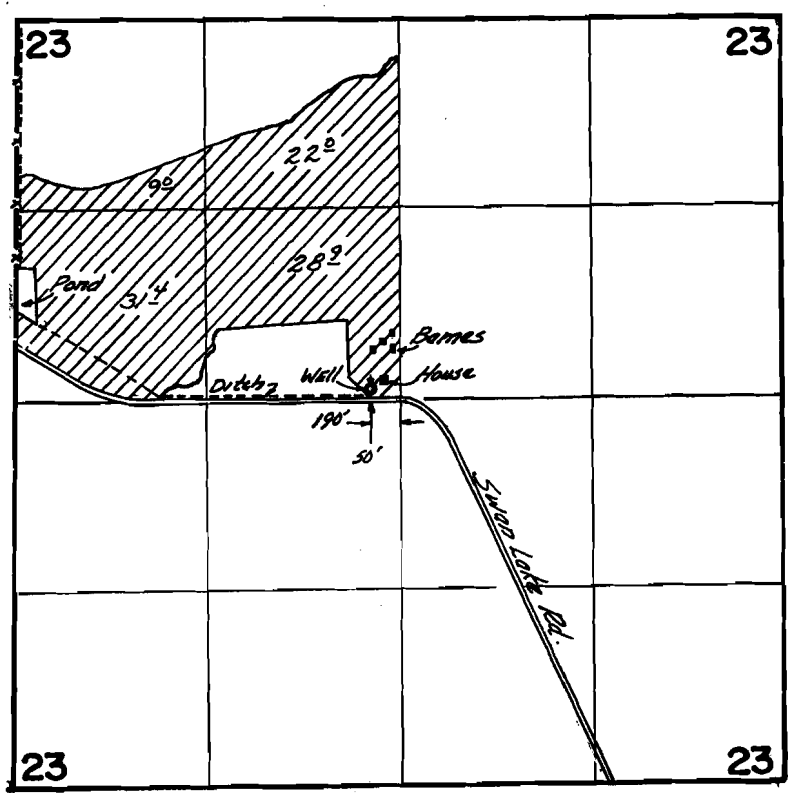

FINAL PROOF SURVEY UNDER

Application No. G-6024 Permit No. G-5146...
IN NAME OF

Lloyd Ray & Carol D. Golbek.....

Surveyed Sept..20. 1979.. by C.R.RODRIGUEZ