


G- 5328
56747

T. 2N., R. 33E., W.M.

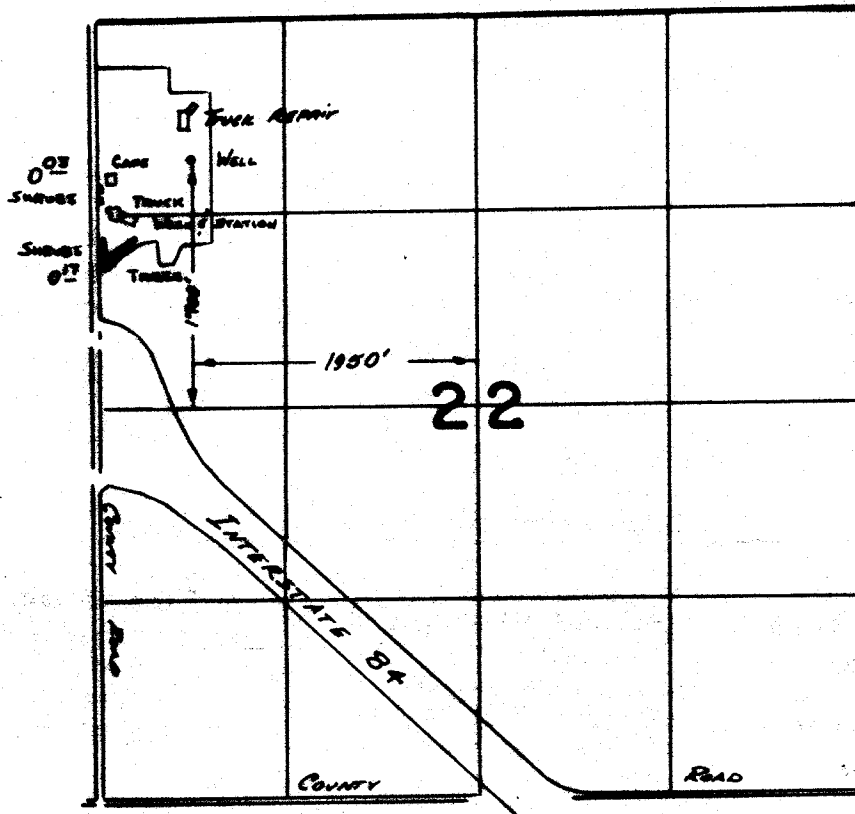

FINAL PROOF SURVEY
UNDER

Application No. G-5623 Permit No. G-5328
IN NAME OF

GEORGE F. BURRIGT

Surveyed June 15, 1922, by K. SAUNDERS

Tuittuilla Creek Wells