


T. 2S., R. 2W., W.M.

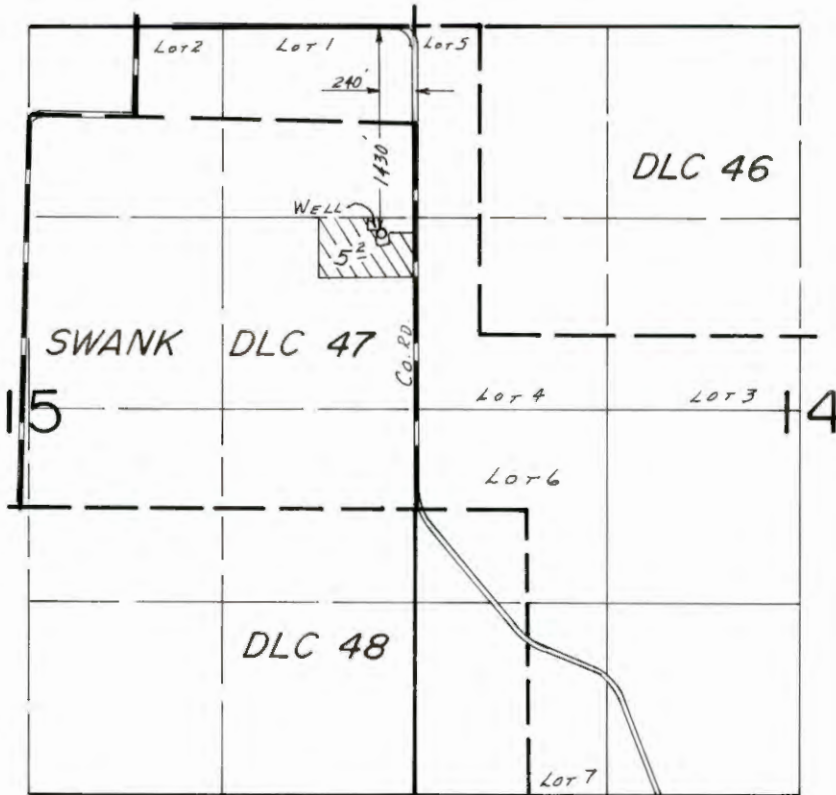

SCALE: 1"=1320'

FINAL PROOF SURVEY
UNDER

Application No. G-6539 Permit No. G-6144.....
IN NAME OF

CLOYD V. HANKINS

Surveyed July 17, 1984, by B.W. BISHOP.....