


T.4S.,R.3W.,W.M.

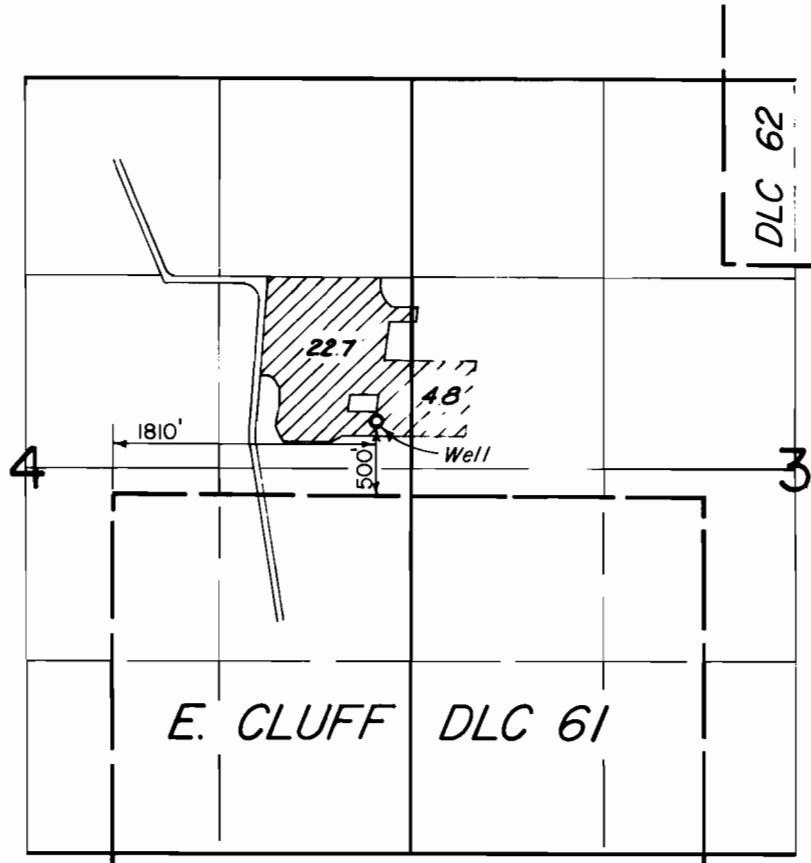

**FINAL PROOF SURVEY**  
UNDER

Application No. G-7196 Permit No. G-6703  
IN NAME OF

K. DURANT & W. BLOSSER

Surveyed JUNE 4, 1980, by McBrien