


T. 34 S., R. 1 W., W.M.

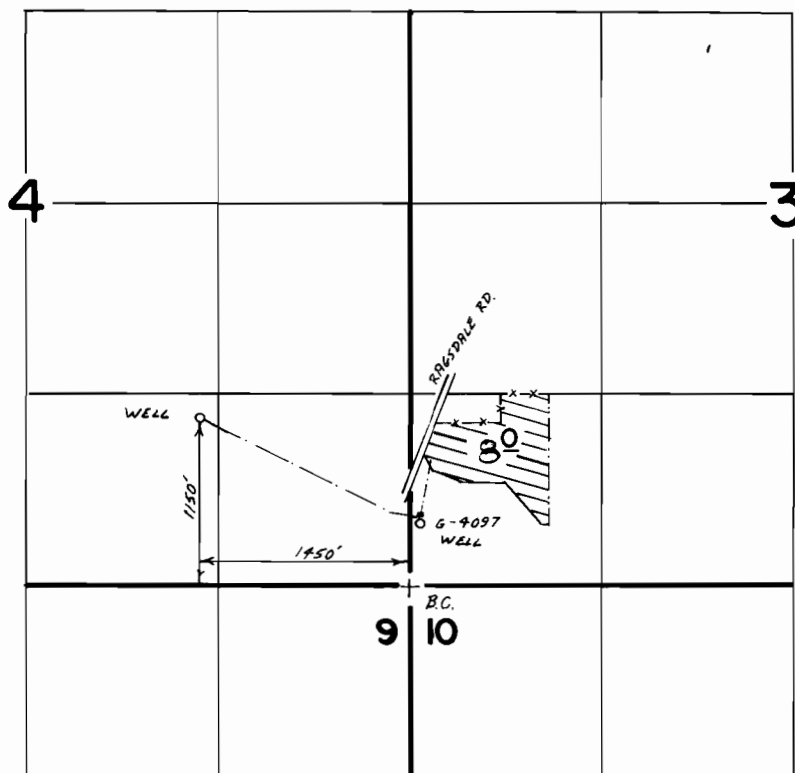

Scale 1" = 1320'

FINAL PROOF SURVEY UNDER

Application No. G-7023 Permit No. G-6800...
IN NAME OF

.....
Surveyed Nov. 5, 1985, by B. S. JAMES.....