


# T.4S.,R.4W.,W.M.

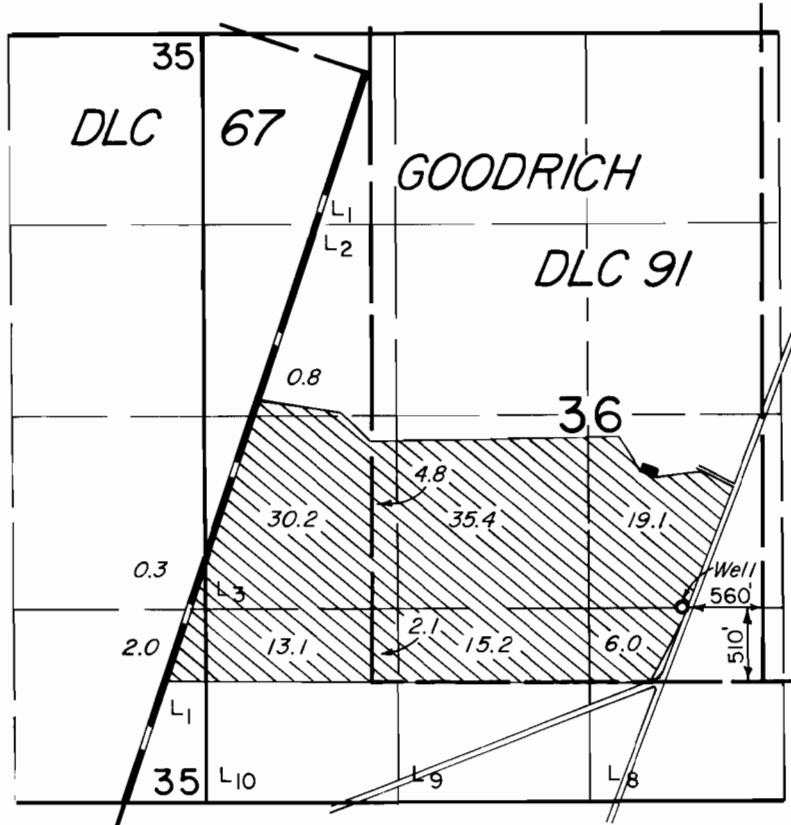

## FINAL PROOF SURVEY UNDER

Application No. G-9187 Permit No. G-8559  
IN NAME OF

HAROLD A. & DARLENE M. HOP

Surveyed MAY 29, 1980, by *dlb*