


T.8S.,R.5W.,W.M.

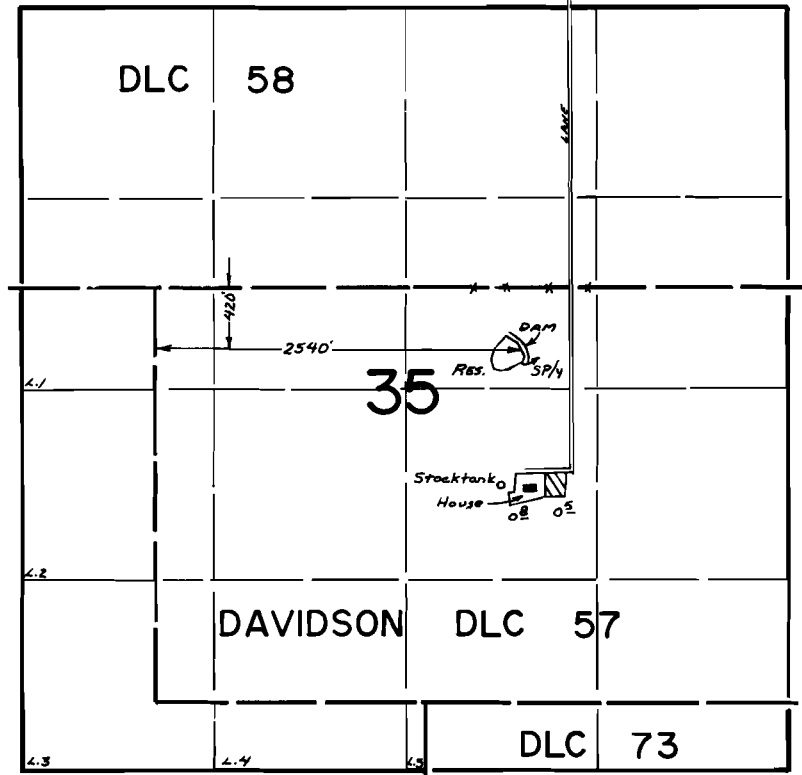

FINAL PROOF SURVEY UNDER

R-51220 R-6213
Application No. .51221.. Permit No. .38697.....
IN NAME OF

.....**JOHN W. LAMERS**.....

Surveyed Sept...11.. 1981.. by ..L...TOLL.....