


# T.8S.,R.5W.,W.M.

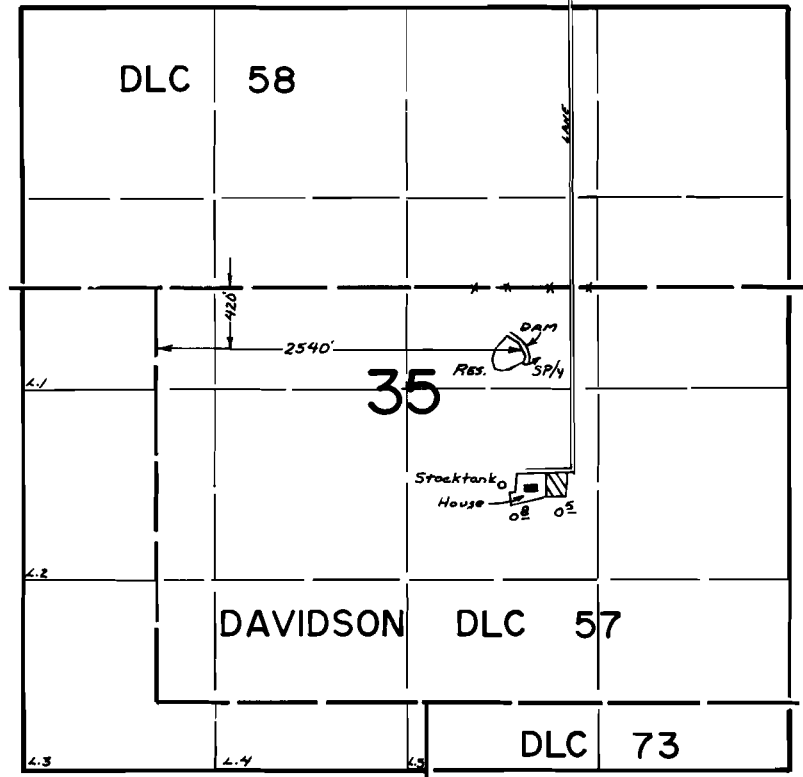

## FINAL PROOF SURVEY UNDER

R-51220                      R-6213  
Application No. 51221.. Permit No. 38697.....  
IN NAME OF

.....**JOHN W. LAMERS**.....

Surveyed Sept...11.. 1981.. by ..L...TOLL.....