


T. I. S., R. I. E., W. M.

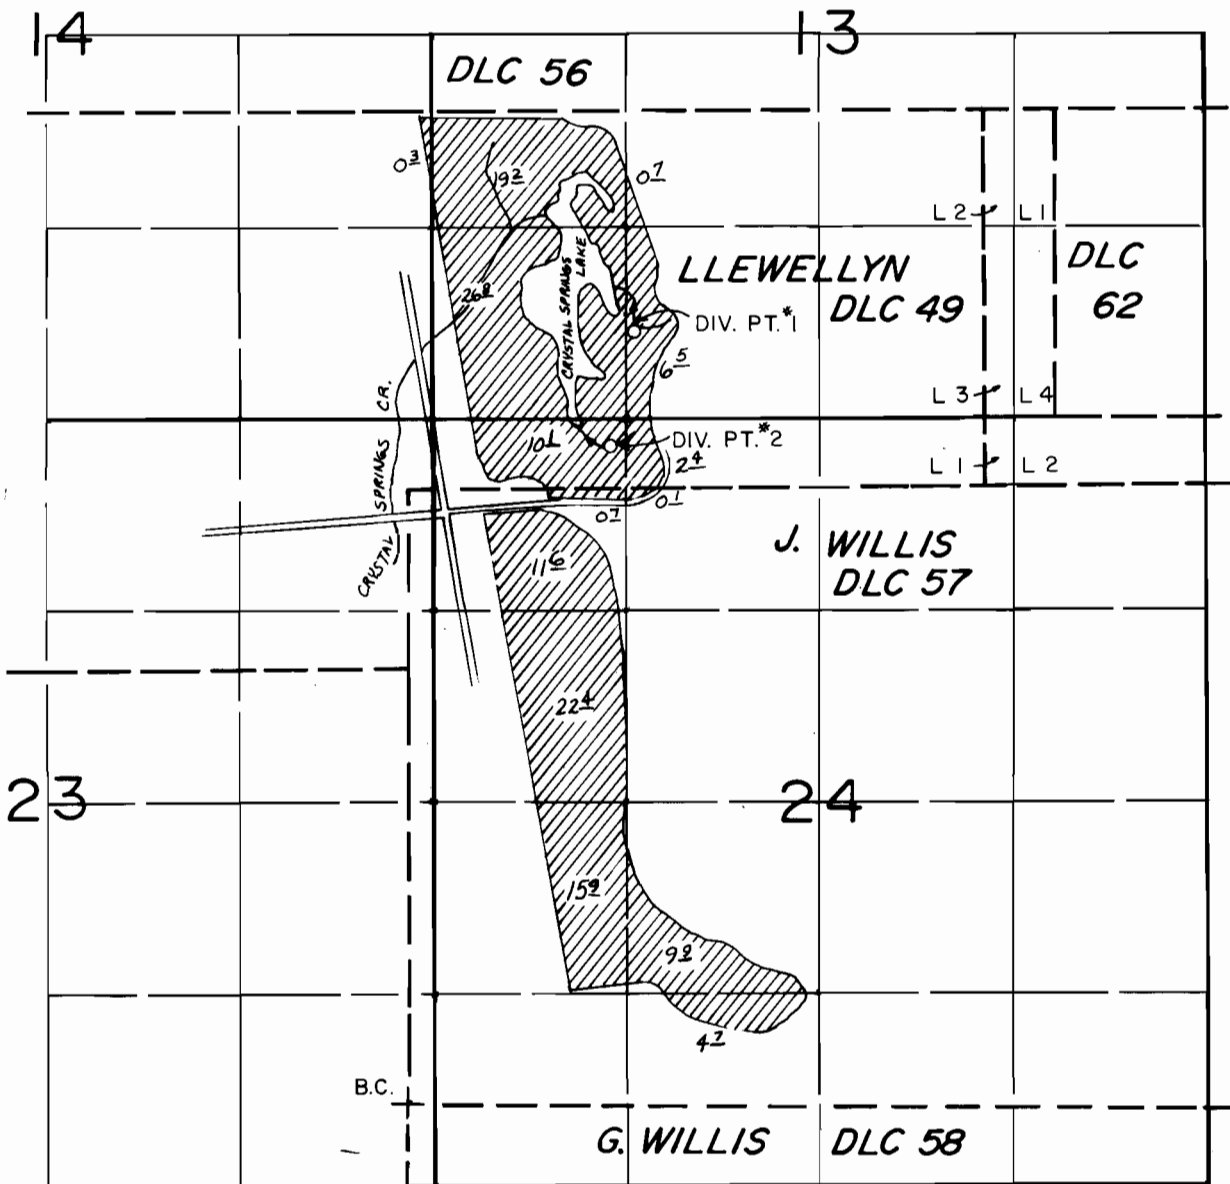

DIV. PT. 1: 5400' N. & 1550' E., DIV. PT. 2: 4500' N. & 1370' E., BOTH FROM THE N.W. CORNER OF G. WILLIS DLC 58.

FINAL PROOF SURVEY UNDER

SCALE: 1" = 1320'

Application No. 41283 Permit No. 30829
IN NAME OF

BUREAU OF PARKS, CITY OF PORTLAND

Surveyed MAY 2, 1984, by P. R. PAGTER