


T. 41 S., R. 8 W., W. M.

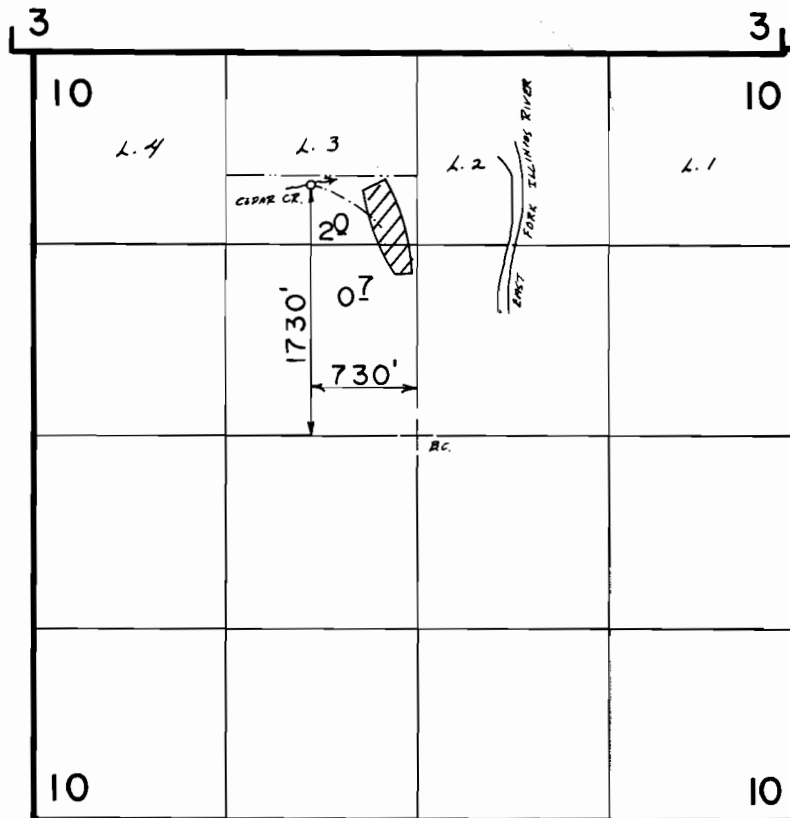

Scale: 1" = 1320'

FINAL PROOF SURVEY
UNDER

Application No. **44340** Permit No. **32738**
IN NAME OF

NORMAN & MARJORIE HARRIS

Surveyed APR. 23. 19.86, by B. S. JAMES...