


T. 33 S., R. 2 W., W.M.

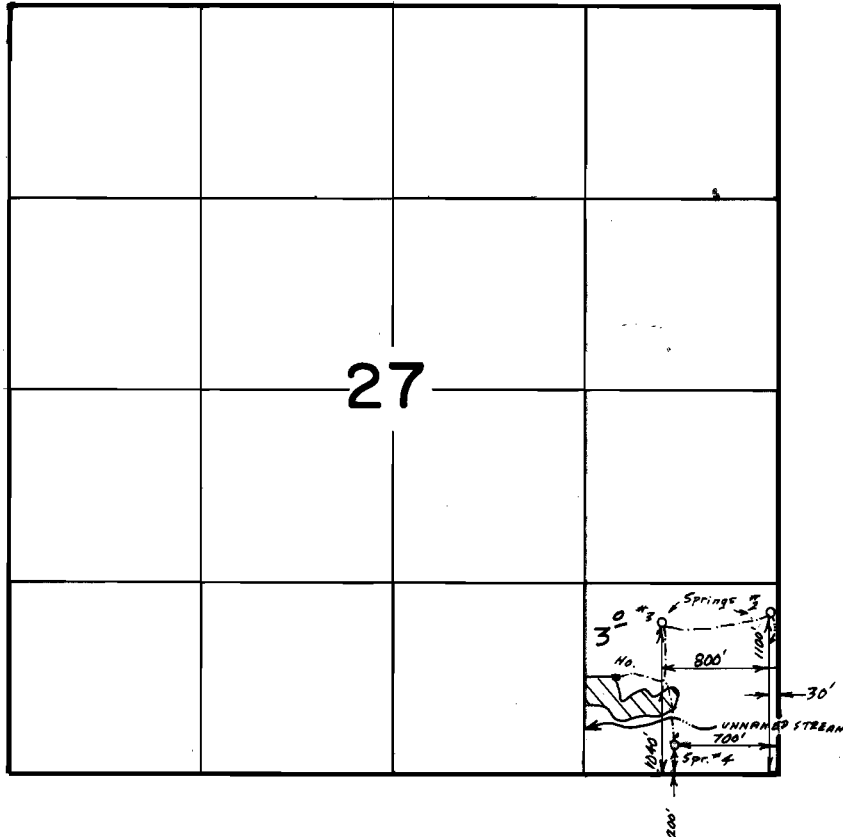

Scale 1" = 1320'

**FINAL PROOF SURVEY**  
UNDER

Application No. ~~44590~~ Permit No. ~~33376~~.....  
IN NAME OF

.....DAVID NEVILLE.....

Surveyed July 22, 1986, by B.S. JAMES.....