


T. 39 S., R. 7 W., W. M.

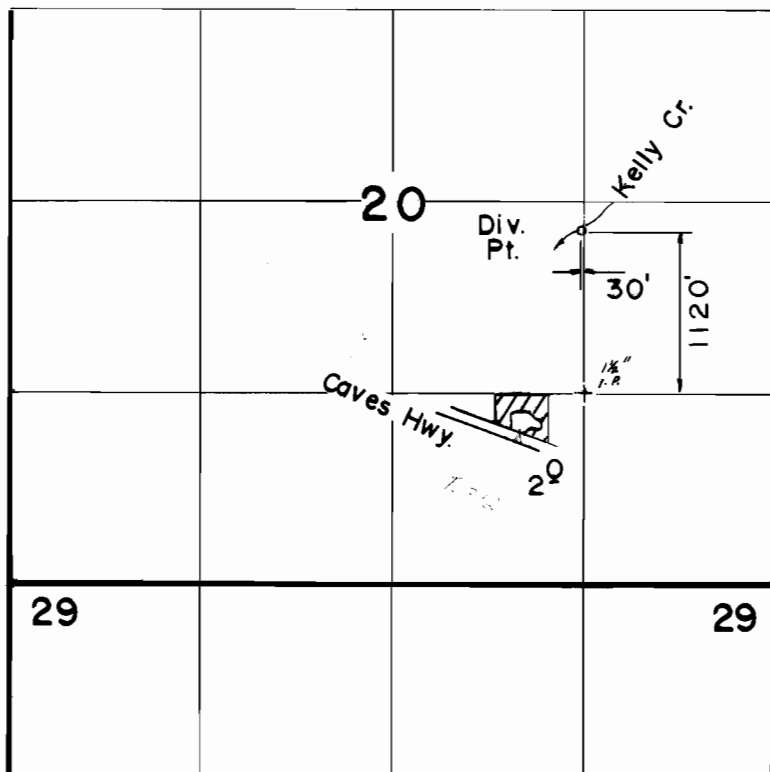

Scale: 1" = 1320'

**FINAL PROOF SURVEY**  
UNDER

Application No. 44927 Permit No. 33688  
IN NAME OF

.....  
Surveyed MAY 15, 1986, by B. S. JAMES.