



T.37S. R.1W. W.M.

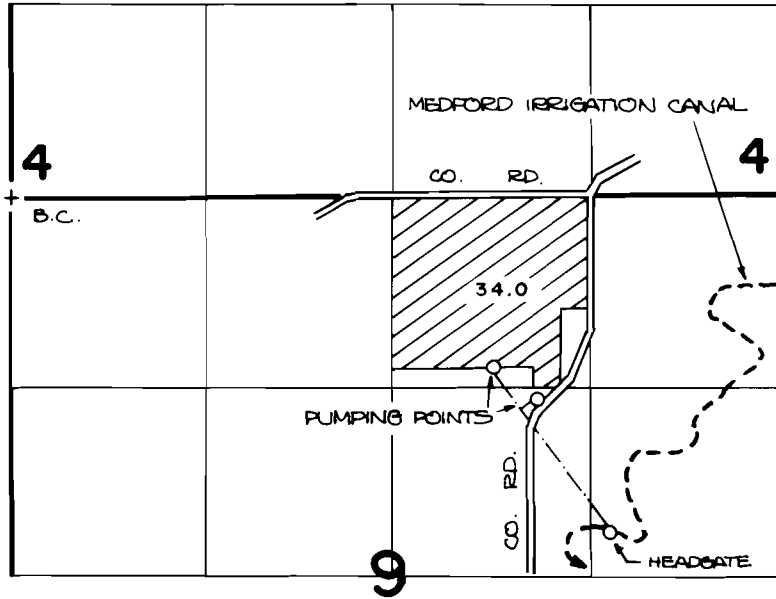

T.36S. R.2E. W.M.

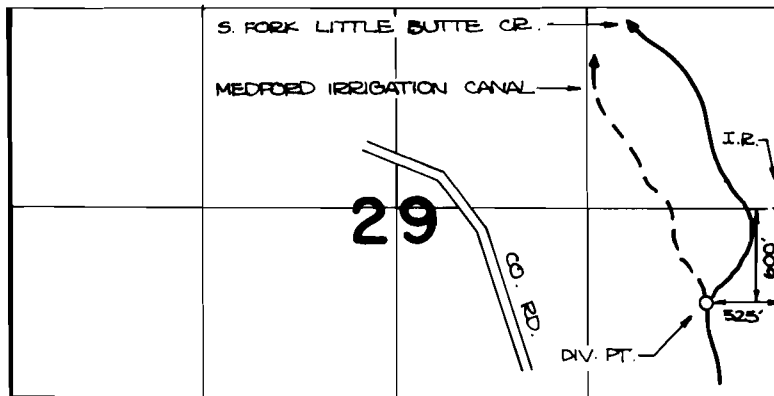

**FINAL PROOF SURVEY
UNDER**

Application No. ~~46690~~ Permit No. ~~34411~~.....
IN NAME OF

ASSOCIATED.....FRUIT.....CO...

Surveyed **APR. 18, 19.83**, by **B...JAMES**.....