


T. 40 S., R. 9 W., W. M.

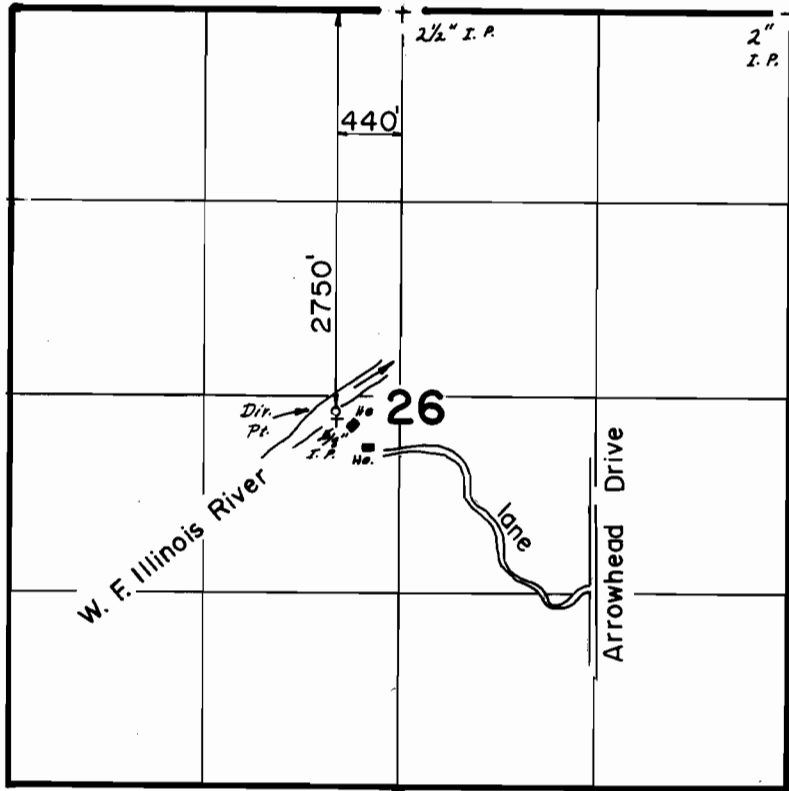

Scale: 1" = 1320'

FINAL PROOF SURVEY
UNDER

Application No. 47074 Permit No. 35206.
IN NAME OF

JANE SOLOFRA

Surveyed MAY 7, 1986, by B. S. JAMES.