


T.4N.R.3W.W.M.

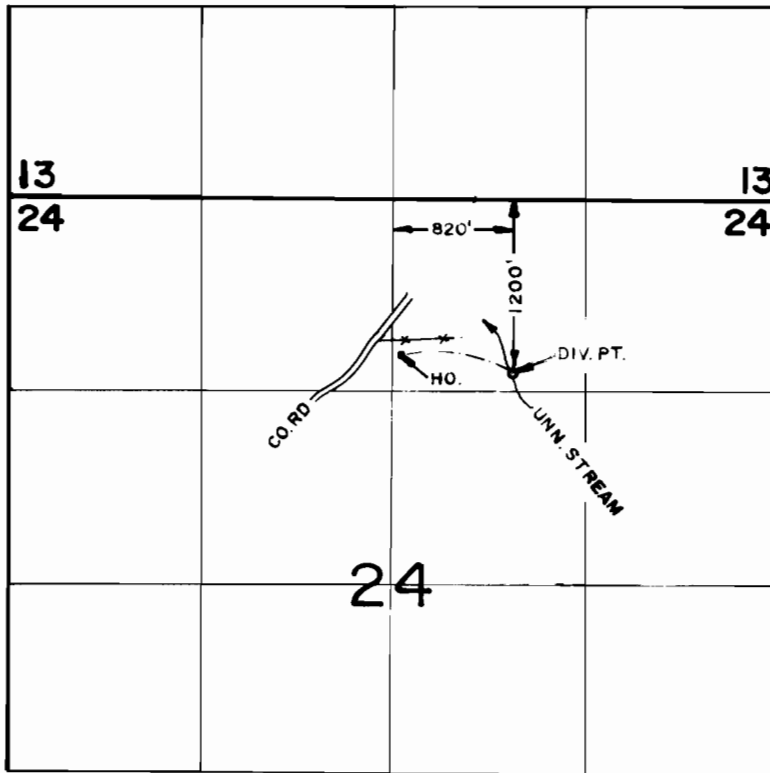

FINAL PROOF SURVEY UNDER

Application No. .47117.... Permit No. .35280....
IN NAME OF

.....DONNA M. TUCKER.....

Surveyed APRIL 10, 1980, by R.G. MUCKEN.....