


T. 33 S., R. 6 W., W. M.

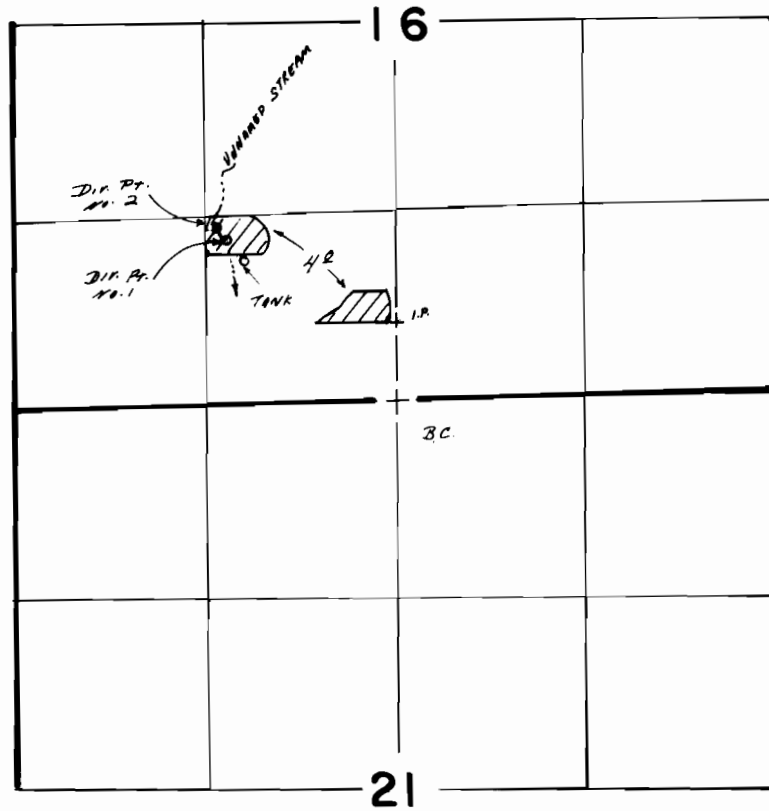

DIVERSION No. 1: 1150' N., 1170' W.; No. 2: 1200' N., 1250' W.;
BOTH FROM S 1/4 COR. SEC. 16

Scale: 1" = 1320'

FINAL PROOF SURVEY UNDER

Application No. 50097. Permit No. 37642..
IN NAME OF

DR. W. D. & CORALEE NAYLOR

Surveyed APR. 30. 1986, by B. S. JAMES...