


P-37954

C-56768

T.13S., R.31E., W.M.

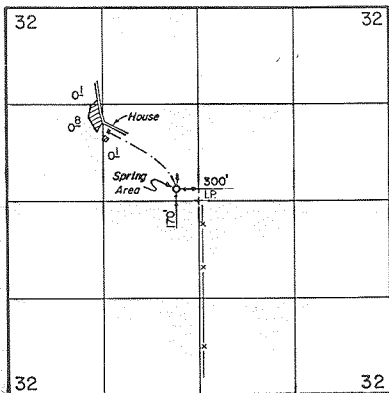

FINAL PROOF SURVEY
UNDER

Application No. 50186 Permit No. 37954
IN NAME OF

WILLIAM L. TOWEILL

Surveyed JUNE 17, 1980, by *W. L. Towell*