


T.13S. R.5W. W.M.

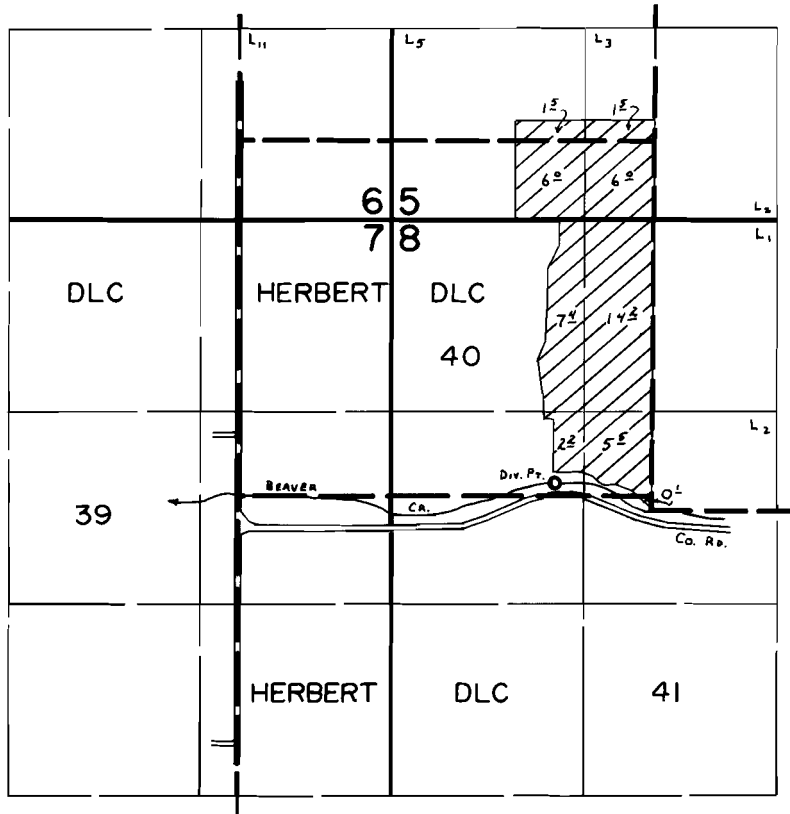

Div. Pt. Loc: 1825'S. & 1130'E. fr. N.W. Cor. Sec. 8.

FINAL PROOF SURVEY UNDER

Application No. .5531.6. Permit No. ...41486...
IN NAME OF

.....**DAN HAYS**.....

Surveyed .May..29.. 19.80, by ...C...L...Hughes.....