


T.13S. R.6W. W.M.

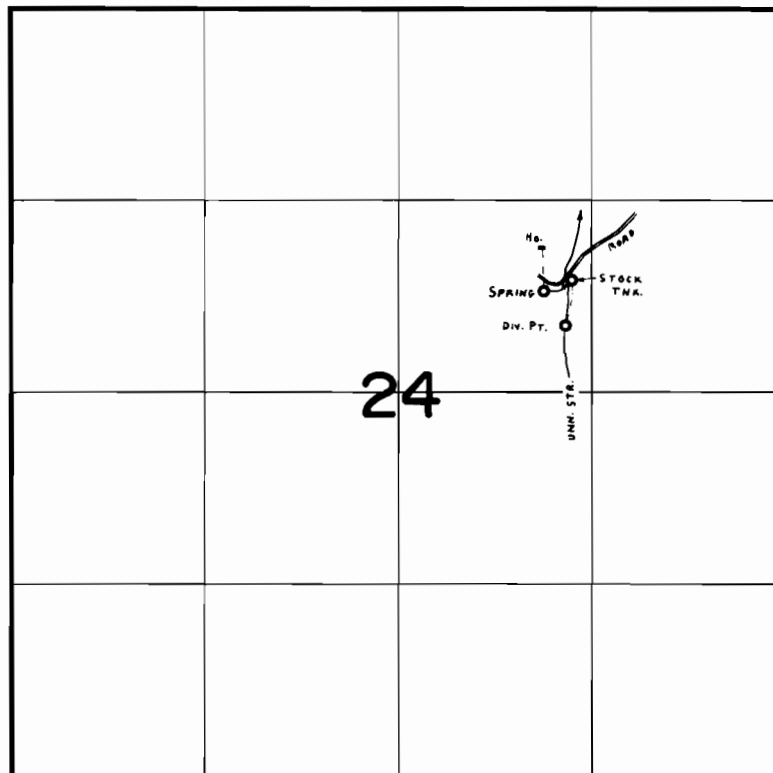

DIV. PT. LOC: 960' N. & 1500' W. } BOTH FROM E. 1/4 COR. SEC. 24.
SPRING LOC: 700' N. & 1650' W. }

FINAL PROOF SURVEY
UNDER

Application No. 51540 Permit No. 38886
IN NAME OF

CURRIER PLACE, INC.

Surveyed May 29 1980, by C. L. Hughes