


T.4S.,R.5W.,W.M.

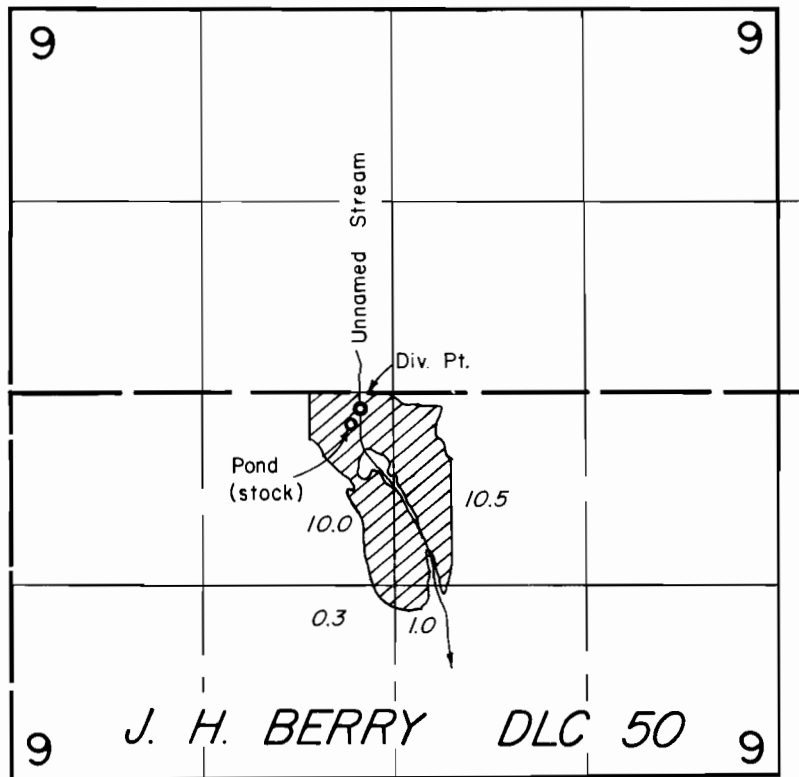

Div. Pt. Loc.: 110' S. & 230' W., from the center Section 9

FINAL PROOF SURVEY
UNDER

Application No. 51920 Permit No. 39162

IN NAME OF

MATTHEW E. DUNCKEL

Surveyed JUNE 3, 1980, by *M. E. Dunckel*