


T.I.S. R.II W.W.M.

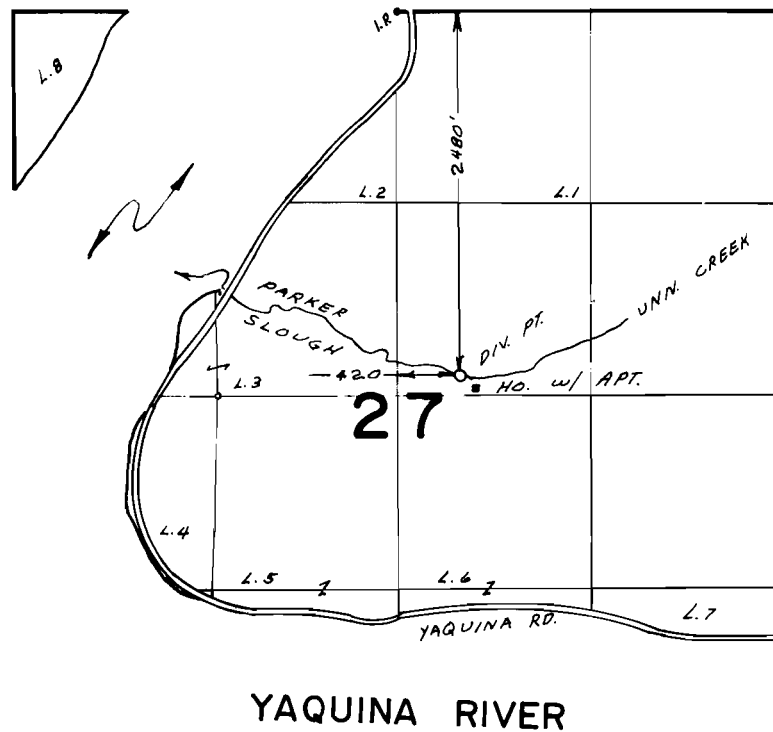

FINAL PROOF SURVEY
UNDER

Application No. 51977..... Permit No. 39166.....
IN NAME OF

.....J.E. & F.H. WRIGHT.....

Surveyed AUG. 10. 1976, by L.H. NUNN.....