


T.12S. R.5W. W.M.

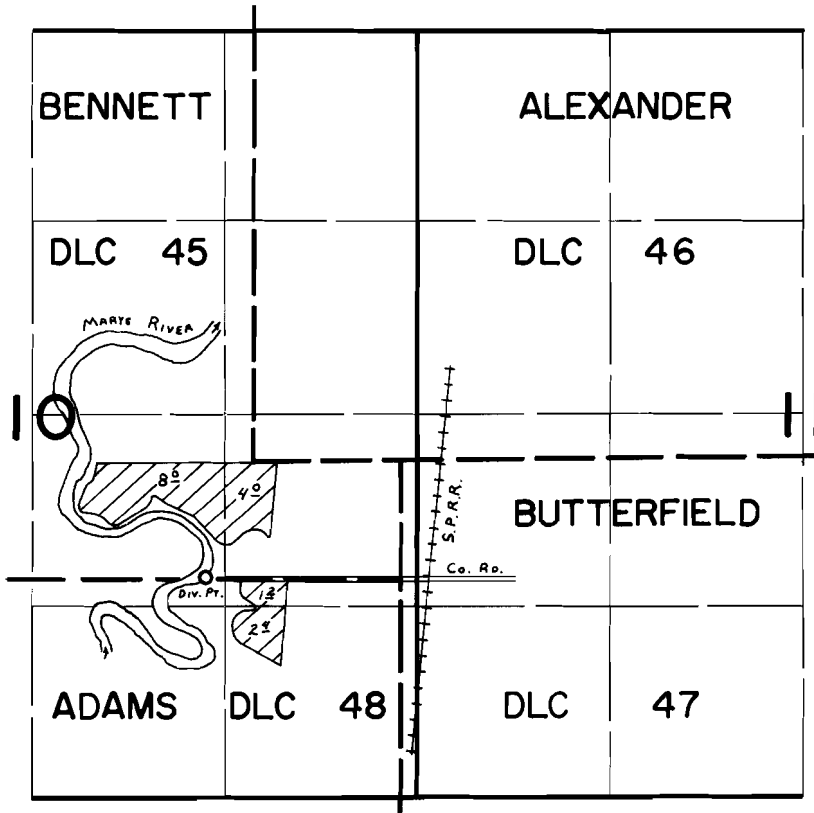

Div. Pt. Loc: 10' N. & 1340' W. fr. N.E. CoR. Adams DLC 48.

**FINAL PROOF SURVEY**  
UNDER

Application No. 53238. Permit No. 39376.....

IN NAME OF

HERBERT CREW

Surveyed May 27, 1980, by C.L. Hughes.....