


T.15S., R.3W., W.M.

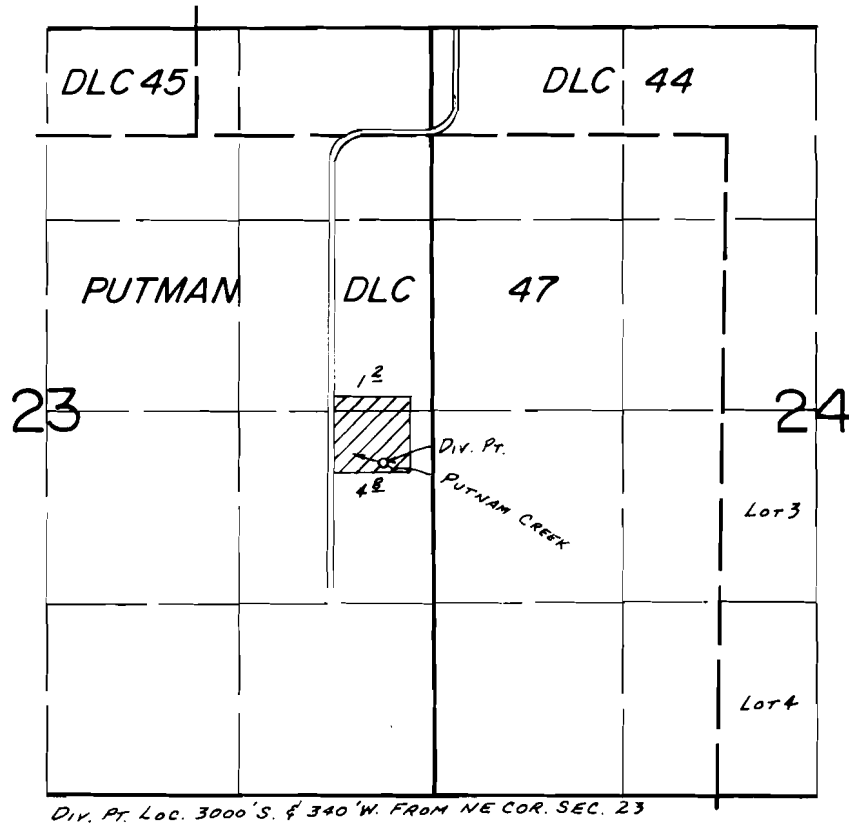

FINAL PROOF SURVEY
UNDER

Application No. 54434.. Permit No. 40821.....
IN NAME OF

GORDON K. & PEGGY ANN JONES.....

Surveyed JULY 2.... 19.80., by S.C. BROWN.....