


T.4S.,R.3W.,W.M.

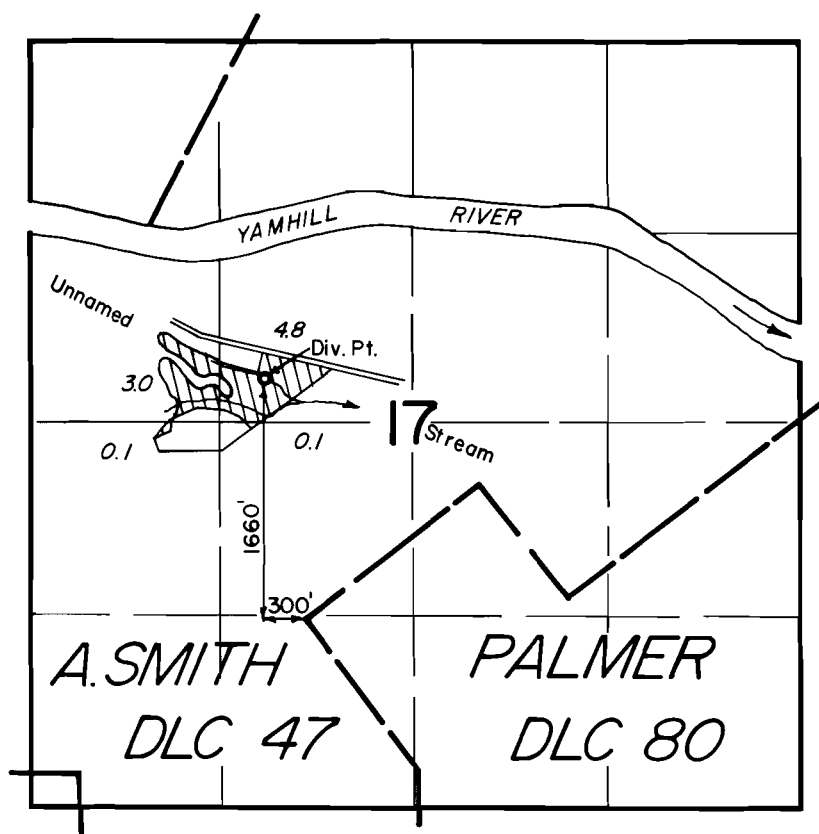

**FINAL PROOF SURVEY**  
UNDER

Application No. 54596 Permit No. 40965...

IN NAME OF

O. T. CALLAHAN

Surveyed JUNE 4, 1980, by *[Signature]*