


T.14S. R.9W. W.M.

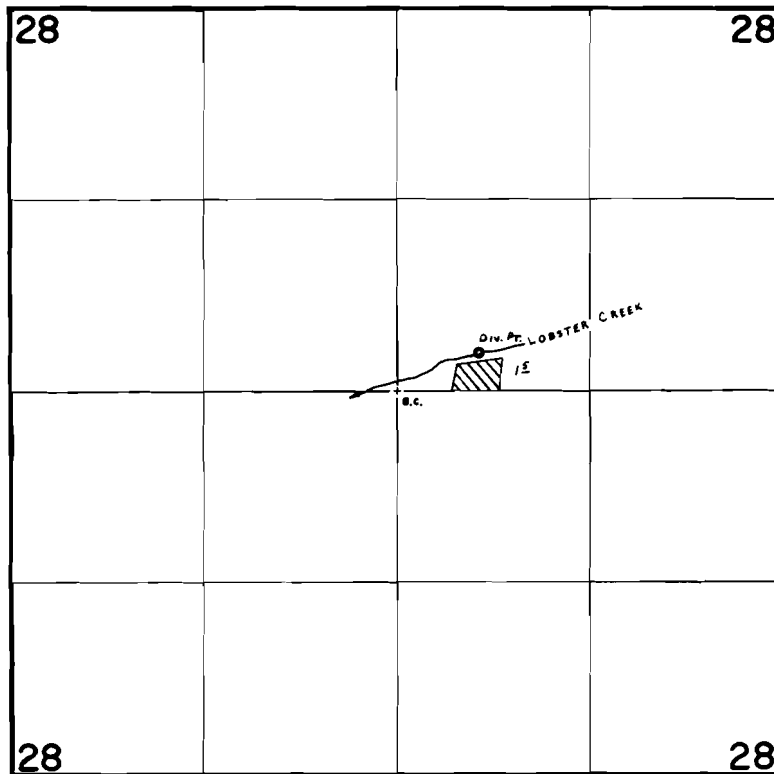

Div. Pt. Loc: 260' N. & 560' E. fr. C. 1/4 Cor. Sec. 28.

FINAL PROOF SURVEY
UNDER

Application No. 54447. Permit No. 41439.....
IN NAME OF

.....GRETCHEN T. EDWARDS.....

Surveyed May 20, 1980, by G. L. Hughes.....