


T. 9S., R. 2E., W.M.

SECTION 35

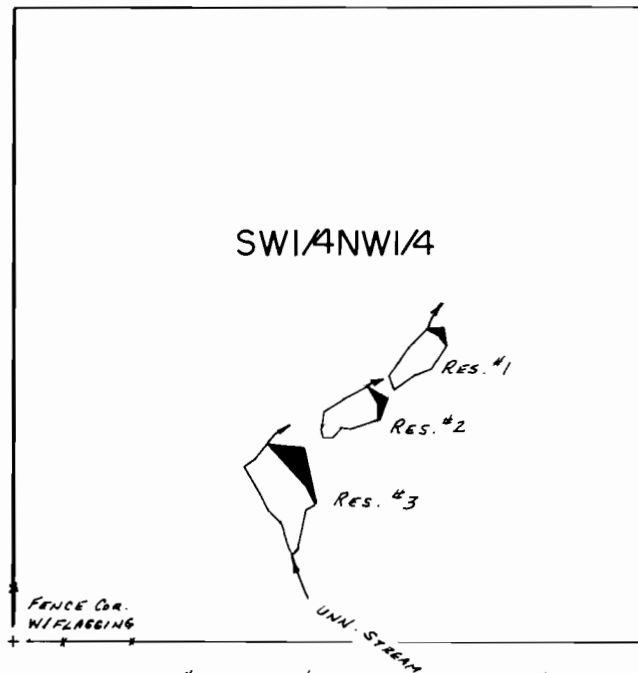

DIV. PTS. LOC.: #1- 650' N. & 880' E., #2- 500' N. & 760' E.,
#3- 380' N. & 580' E., ALL FROM NW 1/4 COR. SEC. 35

SCALE: 1" = 1320'
400'

FINAL PROOF SURVEY

UNDER

R-55140 R-6601
Application No. 55141... Permit No. 41600....
IN NAME OF

.....CATHY A. BALDWIN.....

Surveyed July 17.... 1986, by B.W. BISHOP.....

12/1/86
BWB

PTS 1986 B