


T.10S., R.3W., W.M.

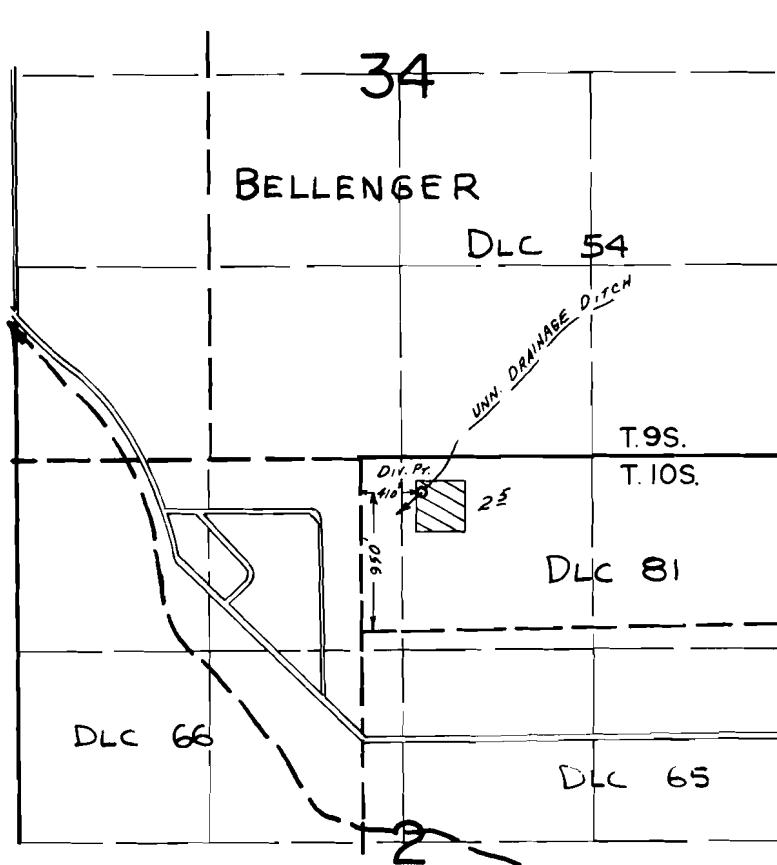

FINAL PROOF SURVEY
UNDER

Application No. 55786 Permit No. 41985
IN NAME OF

ALLEN B. RICE

Surveyed MAY 1 19.80, by C.L. HUGHES