




T. 6 S., R. 10 W., W.M.

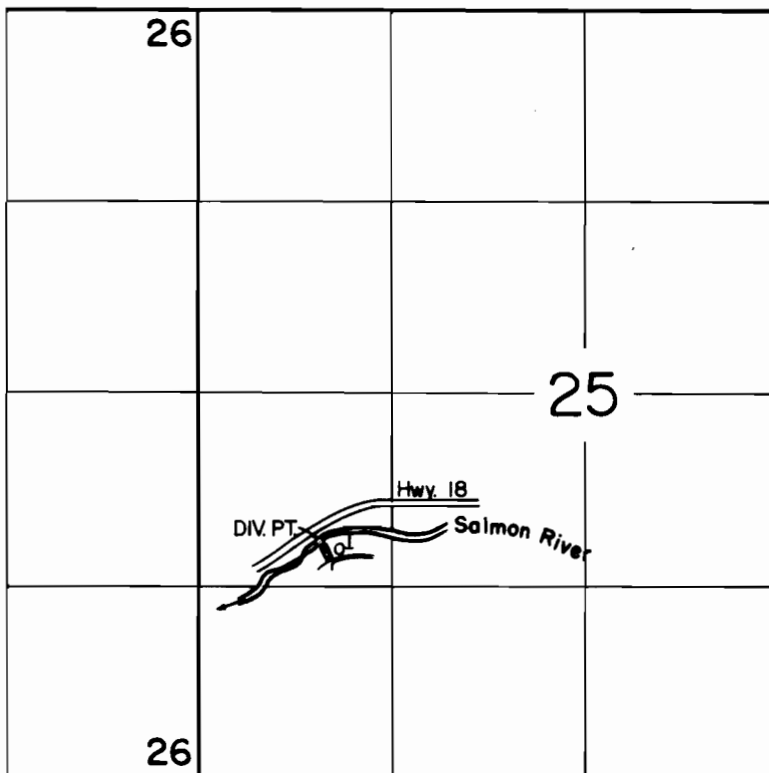

DIV. PT. LOC: 1030' S. & 500' W. FROM N.E. CORNER NW1/4 SW1/4 SEC. 25

SCALE: 1" = 1320'

FINAL PROOF SURVEY
UNDER

Application No. 56203... Permit No. 42301.....
IN NAME OF

ESTATE OF WILLIAM J. GRONAU.....

Surveyed JUNE 19, 1986, by T. WARREN.....