


06295  
NIV

Sec 15 Sec 10

Sec 10 Sec 15

CAMP K  
ESTHER  
APPLEGATE  
CAMP FIRE GIRLS  
AMERICA

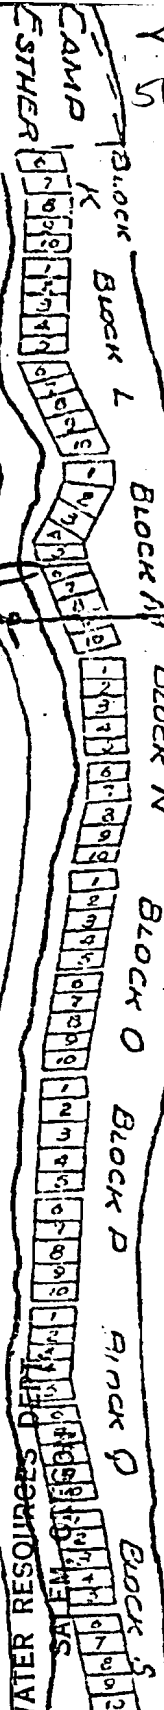

6201 20 AM


RECEIVED

RECEIVED  
MAR 22 1979  
WATER RESOURCES DEPT.  
SALEM, OREGON

House is used where water is used  
LAKE OF THE WOODS

W.M. '25 R. '56 E. '11

Application No. 58436  
44113  
Permit No. Over Pond  
NE Sec. 15  
Glasgow

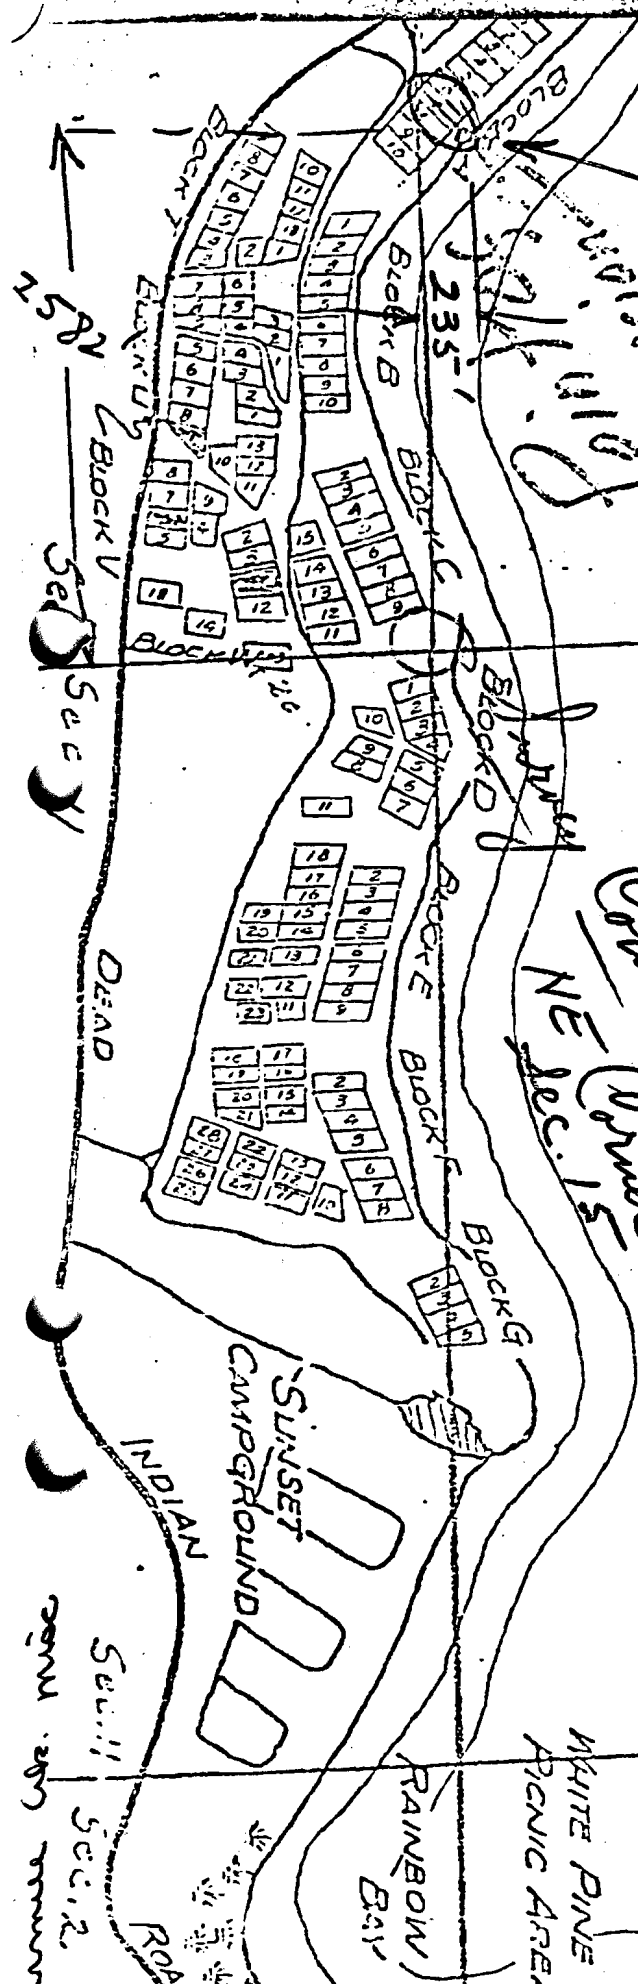

Sec 11 Sec 12

LAKE OF THE WOODS RESOR.  
WHITE PINE  
PICNIC AREA  
RAINBOW BAY  
SUNSET CAMPGROUND  
INDIAN  
ROAD