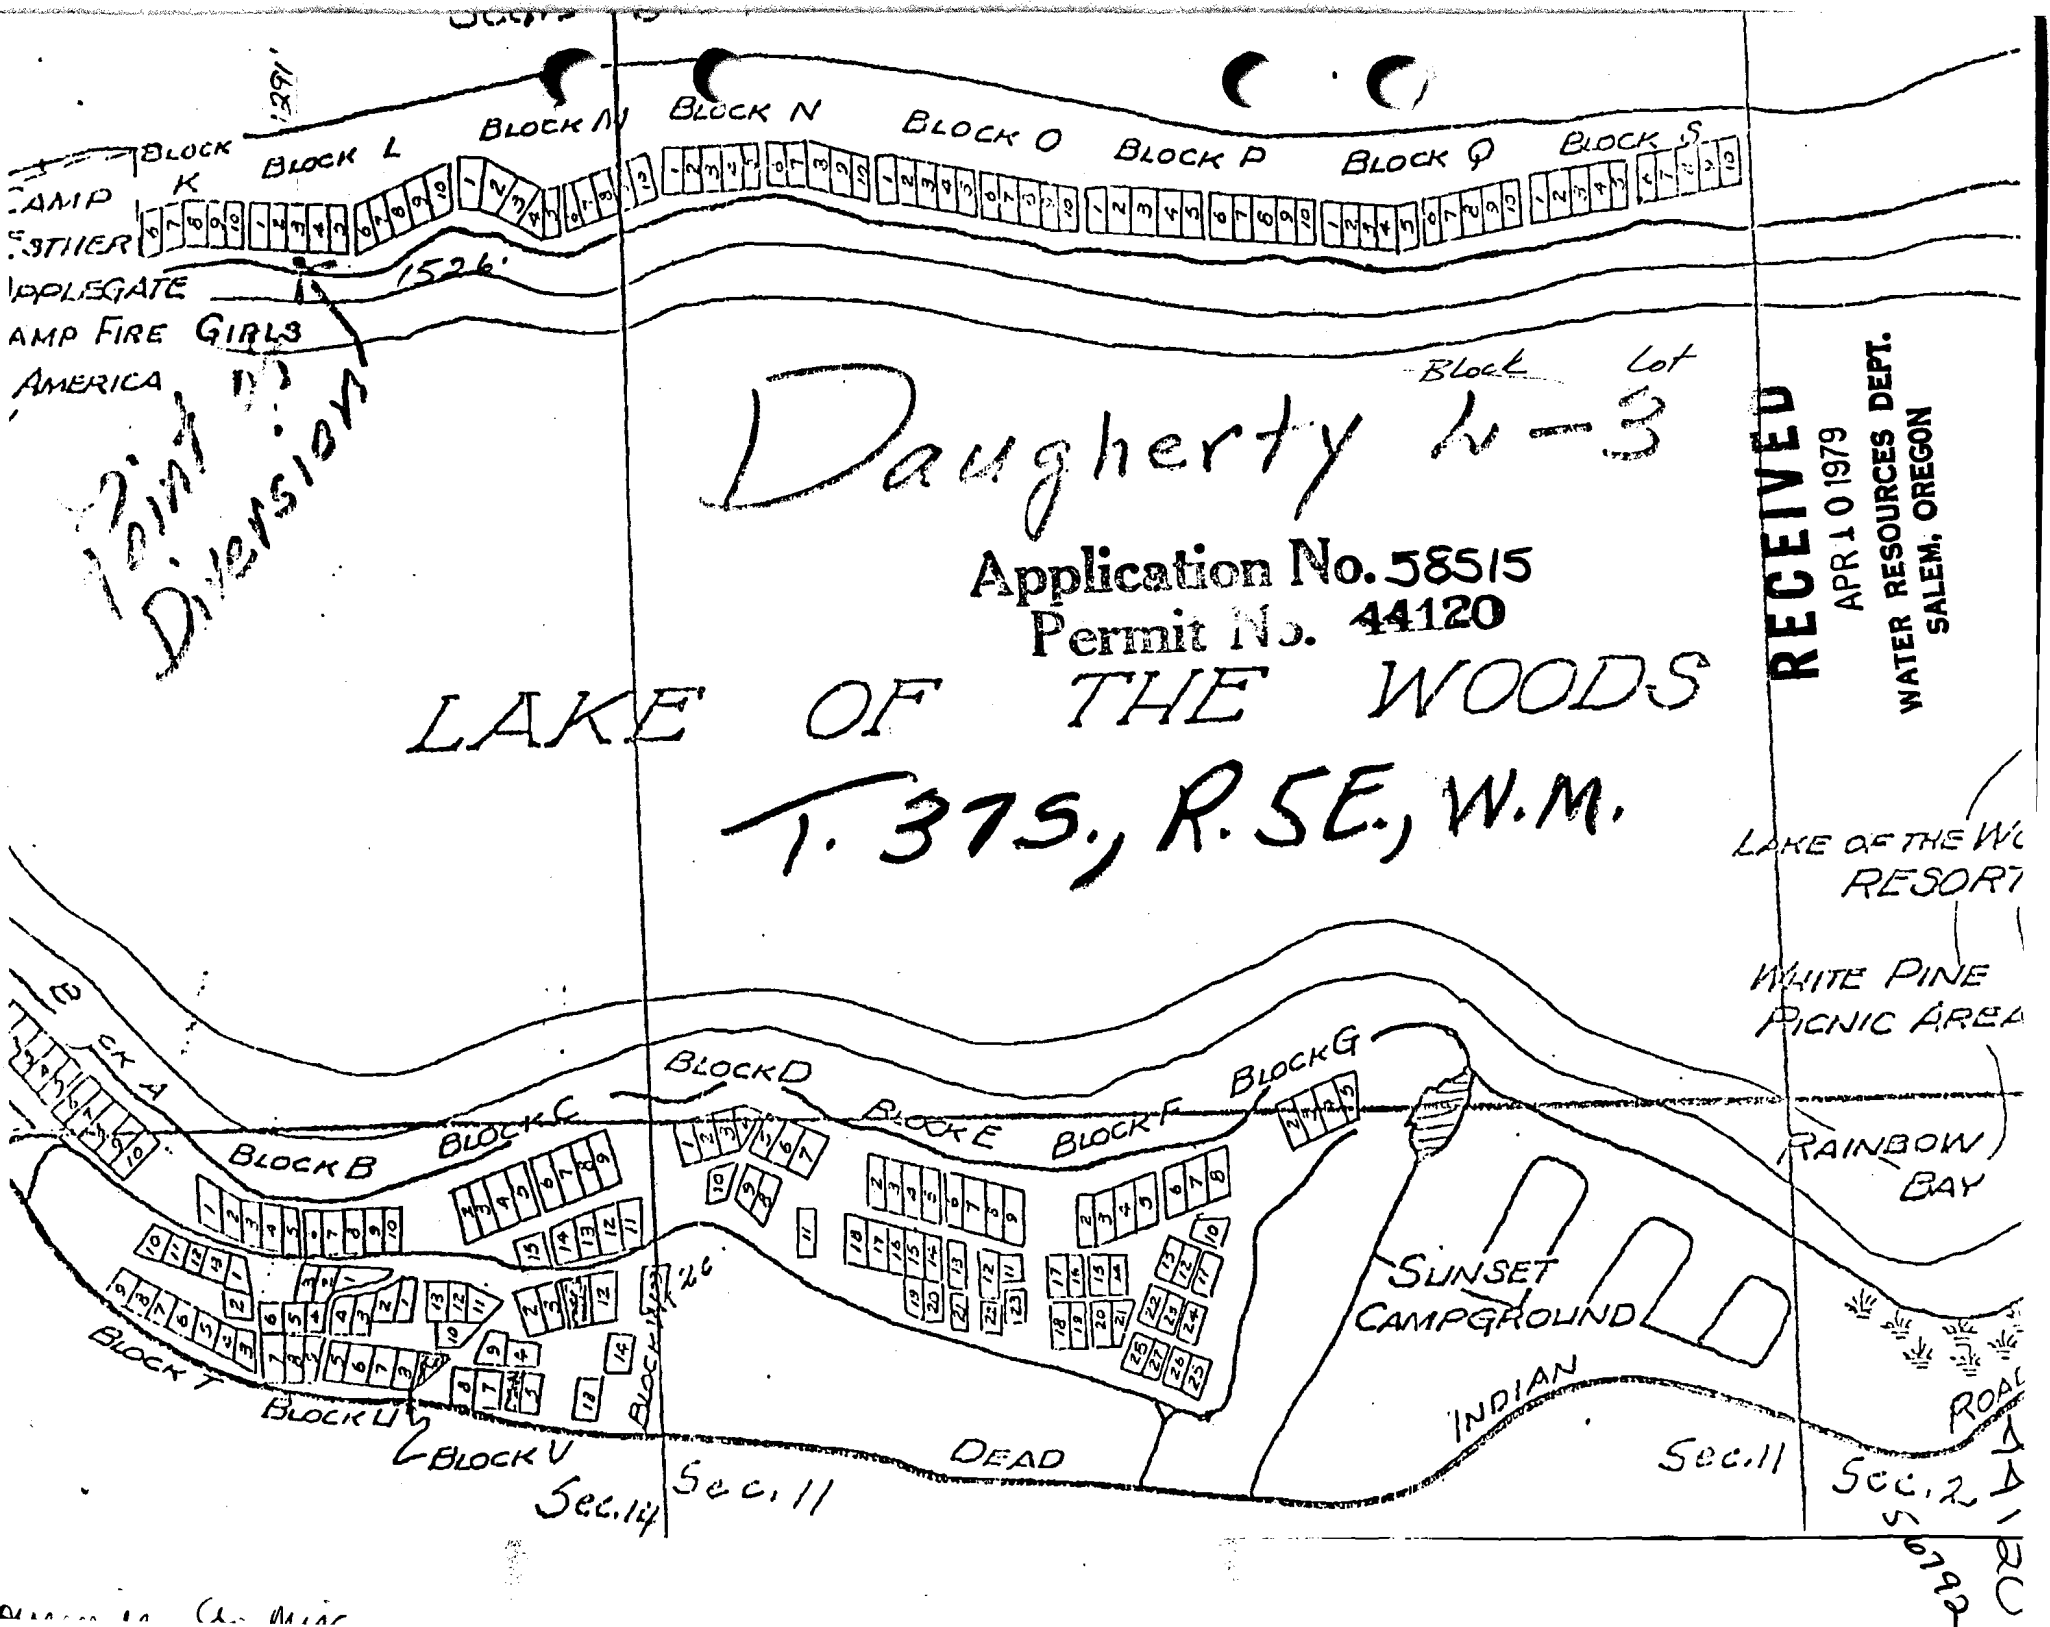
BLOCK K
BLOCK L
BLOCK M
BLOCK N
BLOCK O
BLOCK P
BLOCK Q
BLOCK S
CAMP
STIIER
APPLEGATE
AMP FIRE GIRLS
AMERICA
1526'
Daugherty 4-3
Block Lot
Application No. 58515
Permit No. 44120
LAKE OF THE WOODS
T. 37S., R. 5E., W.M.
RECEIVED
APR 10 1979
WATER RESOURCES DEPT.
SALEM, OREGON
LAKE OF THE WO
RESORT
WHITE PINE
PICNIC AREA
BLOCK A
BLOCK B
BLOCK C
BLOCK D
BLOCK E
BLOCK F
BLOCK G
BLOCK T
BLOCK U
BLOCK V
RAINBOW
BAY
SUNSET
CAMPGROUND
INDIAN
DEAD
Sec. 14
Sec. 11
Sec. 11
Sec. 2
ROAD