


T.10S. R.8W. W.M.

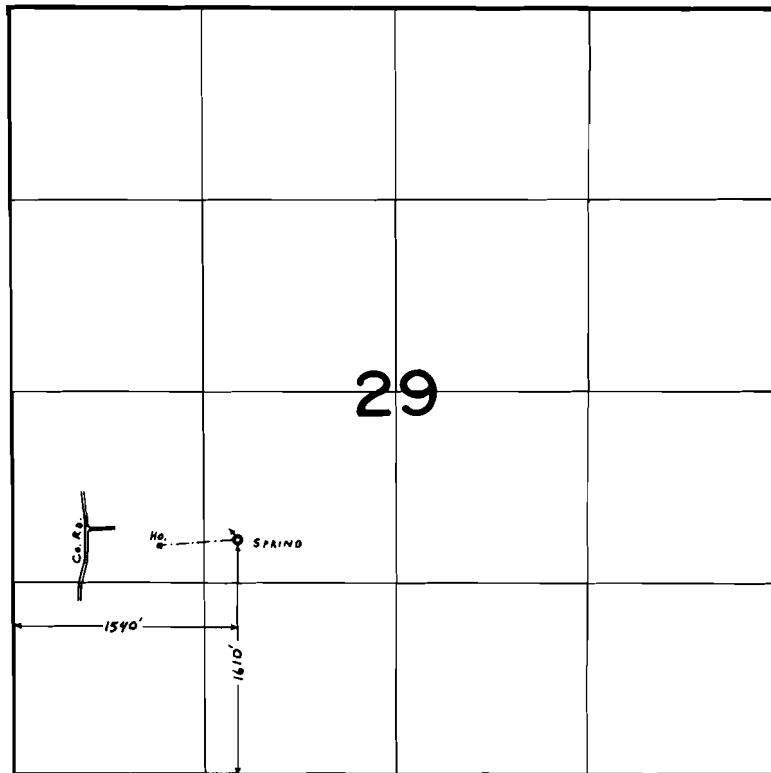

FINAL PROOF SURVEY
UNDER

Application No. ..58691... Permit No. ..44257....
IN NAME OF

...ANTHONY PETER CRUDELE.....

Surveyed May..23.. 1980., by ..C.L.Hughes.....