


08 2475
96195

SECS 13 Sec 14

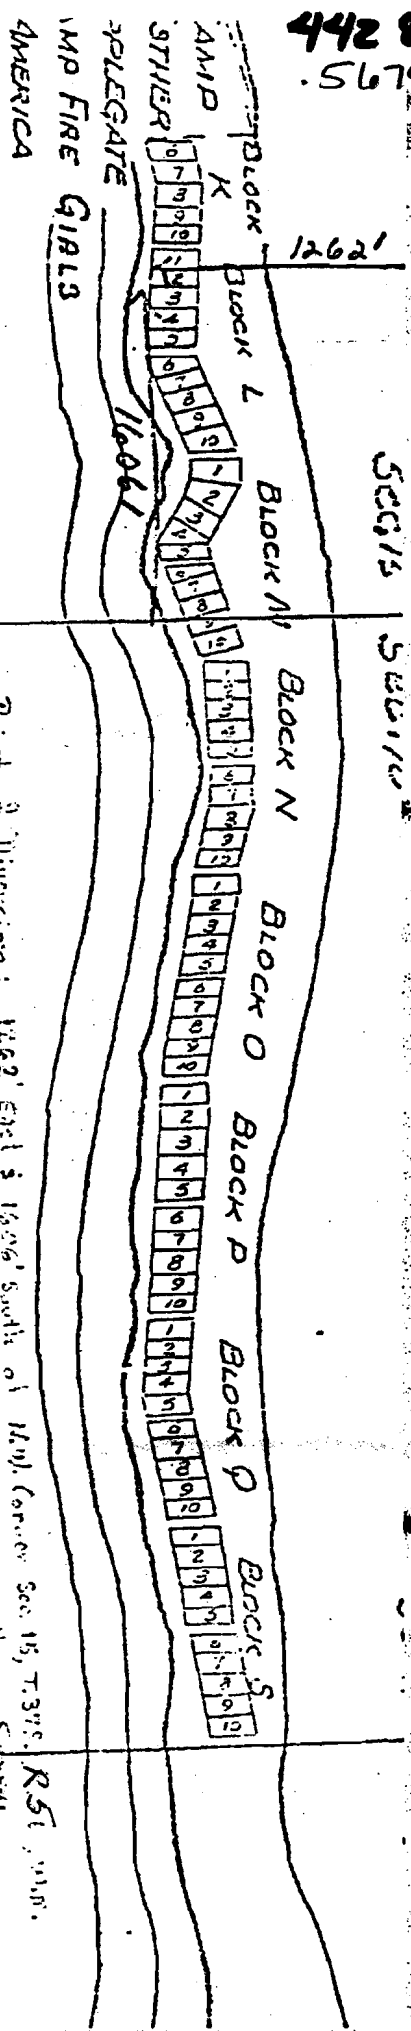

 Point of Use: Lot 2, Tract L, Lake of the Woods Summer House Survey


Application No. 58539
 Permit No. 44280

LAKE OF THE WOODS

RECEIVED

APR 16 1979

WATER RESOURCES DEPT.
 SALEM, OREGON

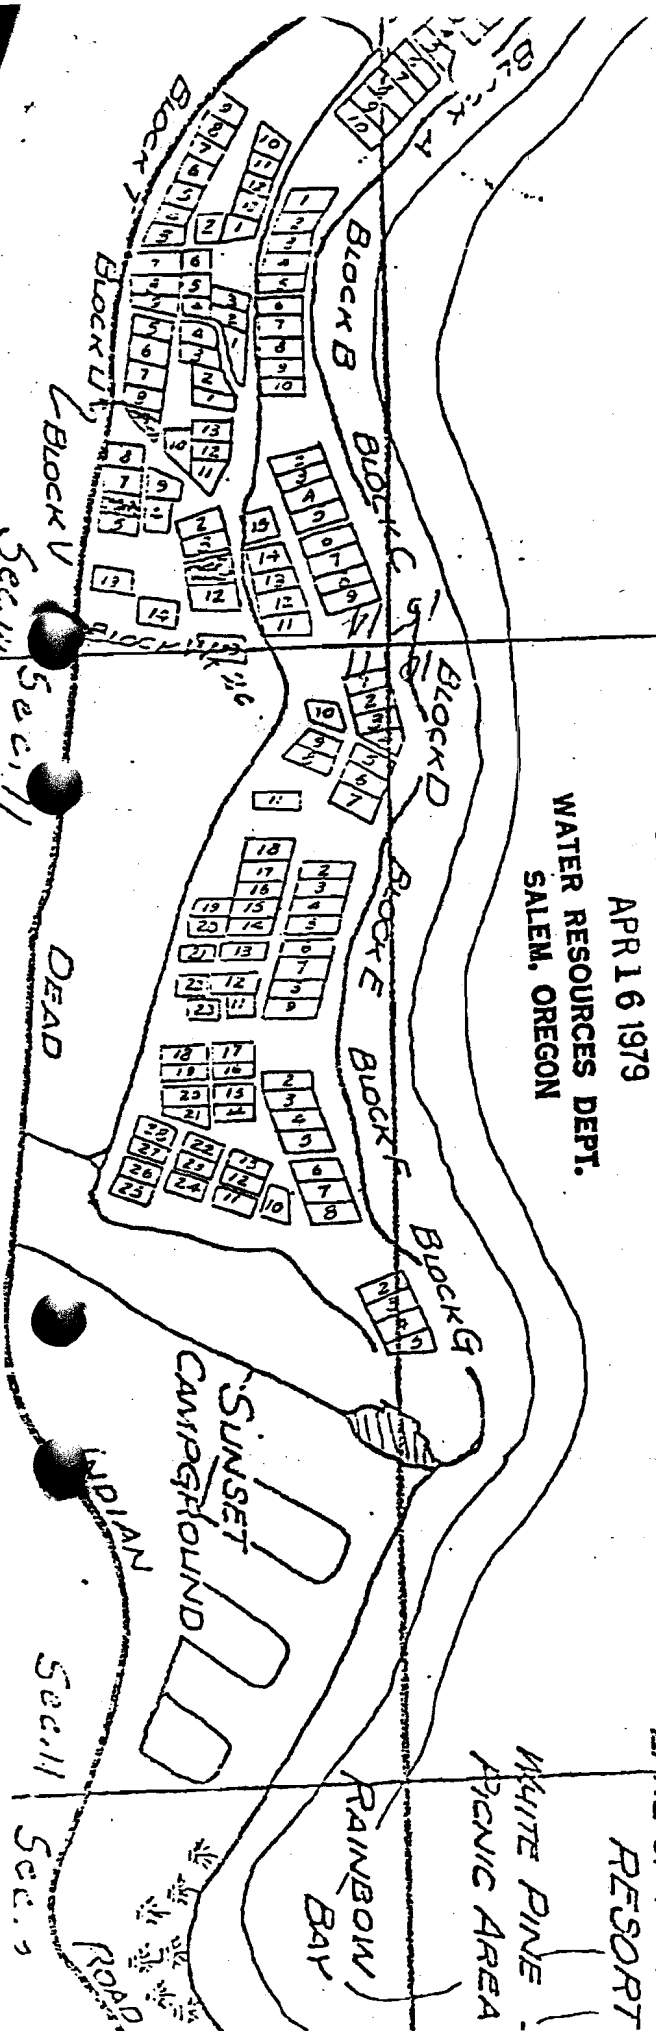

LAKE OF THE WOODS
 RESORT

WHITE PINE
 PICNIC AREA

RAINBOW
 BAY

SUNSET
 CAMPGROUND

WIPYAN
 ROAD

DEAD

Sec 11

Sec 9